


WELL PLUGGING RECORD

Give All Information Completely  
Make Required Affidavit  
Mail or Deliver Report to:  
Conservation Division  
State Corporation Commission  
800 Biting Building  
Wichita, Kansas

NORTH

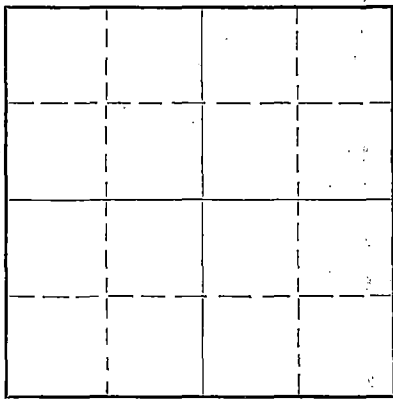

Locate well correctly on above  
Section Plat

Reno County, Sec. 10 Twp. 24S Rge. 4 (E) W (W)  
Location as "NE/CNW 1/4 SW 1/4" or footage from lines CE/2 E/2 NW  
Lease Owner B & R Drilling, Inc.  
Lease Name Brown Well No # 1  
Office Address Russell, Kansas  
Character of Well (completed as Oil, Gas or Dry Hole) Dry Hole  
Date well completed April 20, 1950 19  
Application for plugging filed May 29, 1950 Verbally 19  
Application for plugging approved May 29, 1950 Verbally 19  
Plugging commenced May 30, 1950 19  
Plugging completed June 2, 1950 19  
Reason for abandonment of well or producing formation Dry Hole

If a producing well is abandoned, date of last production 19  
Was permission obtained from the Conservation Division or its agents before plugging was commenced? Yes

Name of Conservation Agent who supervised plugging of this well Ruel Durkee  
Producing formation Depth to top Bottom Total Depth of Well 3428 Feet  
Show depth and thickness of all water, oil and gas formations.

OIL, GAS OR WATER RECORDS

CASING RECORD

Formation	Content	From	To	Size	Put In	Pulled Out
				8 5/8"	454'	None
				5 1/2"	3326'	2964'

Describe in detail the manner in which the well was plugged, indicating where the mud fluid was placed and the method or methods used in introducing it into the hole. If cement or other plugs were used, state the character of same and depth placed, from feet to feet for each plug set.

Plugging Record

Filled hole with mud to 3320', filled from 3320' to 3315' with crushed rock, dumped 6 sax cement at 3315' with dump bailer. Top of cement 3268', filled with mud to 350', set rock bridge, dumped 25 sax cement. Top of cement 293'. Filled with mud to 20' dumped 5 sax cement for cap.

(If additional description is necessary, use BACK of this sheet)

Correspondence regarding this well should be addressed to B & R Drilling, Inc.  
Address Russell, Kansas

STATE OF Kansas, COUNTY OF Russell, ss.  
Don Roberts

(employee of owner) or (owner or operator) of the above-described well,  
being first duly sworn on oath, says: That I have knowledge of the facts, statements, and matters herein contained and the log of the above-described well as filed and that the same are true and correct. So help me God.

(Signature) *[Signature]*

Russell, Kansas  
(Address)

SUBSCRIBED AND SWORN TO before me this 12th day of June, 1950

My commission expires 6-17-50

*[Signature]*  
Notary Public.

23-3273-s 4-50-10M

PLUGGING  
FILE SEC 10 T 24 R 4 W  
BOOK PAGE 8 LINE 30

JUN 14 1950  
STATE CORPORATION COMMISSION  
6-14-50

B & R Drilling, Inc.  
Brown # 1

CE/2 E/2 NW Sec. 10-24S.4W  
Reno County, Kansas

Total Depth: 3340'  
Comm: 4-20-50  
Comp: 5-10-50

Top: Mississippi Lime 3288'

Casing

Cement

8 5/8" Set @ 454'  
5 1/2" Set @ 3326'

225 Sacks Cement  
75 Sacks Cement

Formation	Depth
Surface Sand-Clay	10
Sand-Gravel	125
Shale	135
Sand	205
Shale	245
Sand-Shale	400
Shale-Shell	460
Shale	530
Anhydrite-Shale	705
Shale-Shells	940
Redbed-Salt	950
Shale-Lime -Shell	975
Lime-Shale	1000
Lime	1040
Shale-Lime	3265
Lime-shale	3315
Lime	3340'

STATE OF KANSAS )  
                          ) SS  
RUSSELL COUNTY )

I hereby certify that the above information is true and correct to the best of my knowledge.

*Violet Feller*  
\_\_\_\_\_

Subscribed and sworn to before me this 16th day of May, 1950

*Clara Lamm*  
\_\_\_\_\_ Notary Public

My commission expires: 6-17-50

**PLUGGING**  
FILE SEC-10-24-40  
PAGE 6 LINE 20

RECORDED  
JUN 14 1950  
STATE COMMISSION  
KANSAS