

STATE OF KANSAS
STATE CORPORATION COMMISSION


WELL PLUGGING RECORD

Give All Information Completely
Make Required Affidavit
Major or Deliver Report to:
Conservation Division
State Corporation Commission
800 Bitting Building
Wichita, Kansas

Finney County, Sec. 21 Twp. 24 Rge. 31 (E) (W)

Location as "NE/CNW&SW" or footage from lines SW SW SW
Lease Owner F. Kirk Johnson
Lease Name Lee Kisner Well No. 1
Office Address Box 9338, Fort Worth 7, Texas
Character of Well (completed as Oil, Gas or Dry Hole) Dry Hole
Date well completed December 28, 1955
Application for plugging filed December 28, 1955
Application for plugging approved December 28, 1955
Plugging commenced December 28, 1955
Plugging completed December 28, 1955
Reason for abandonment of well or producing formation Not commercial

NORTH

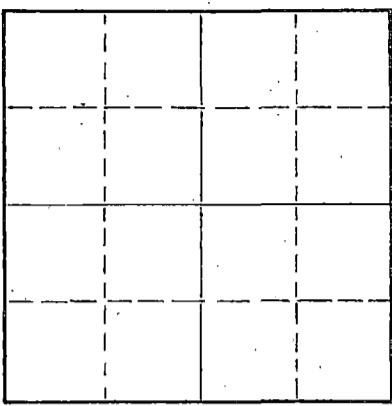

Locate well correctly on above Section Plat

If a producing well is abandoned, date of last production 19
Was permission obtained from the Conservation Division or its agents before plugging was commenced? Yes

Name of Conservation Agent who supervised plugging of this well M. A. Rives, Box 148, Pratt, Kansas
Producing formation Depth to top Bottom Total Depth of Well 5120 Feet
Show depth and thickness of all water, oil and gas formations.

OIL, GAS OR WATER RECORDS

CASING RECORD

| FORMATION | CONTENT | FROM | TO | SIZE | PUT IN | PULLED OUT |
|-----------|------------------|---------|--------|---------------------|--------|------------|
| | 19 joints of new | 10-3/4" | @ 582' | w/750 sacks posmix, | 2% CC | |
| | | | | | | |
| | | | | | | |
| | | | | | | |

Describe in detail the manner in which the well was plugged, indicating where the mud fluid was placed and the method or methods used in introducing it into the hole. If cement or other plugs were used, state the character of same and depth placed, from feet to feet for each plug set.

Cemented with 25 sacks through drill pipe @ 500'
w/15 sacks @ 40' @ 3:30 a.m., 12-28-55.

(If additional description is necessary, use BACK of this sheet)

Name of Plugging Contractor Garvey Drilling Company
Address 311 East Third, Wichita, Kansas

STATE OF TEXAS, COUNTY OF TARRANT, ss.
J. N. Vater, Jr. (employee of owner) or (owner or operator) of the above-described well, being first duly sworn on oath, says: That I have knowledge of the facts, statements, and matters herein contained and the log of the above-described well as filed and that the same are true and correct. So help me God.

(Signature) J. N. Vater, Jr.
3101 Winthrop, Fort Worth, Texas
(Address)

SUBSCRIBED AND SWORN TO before me this 12th day of January, 1956

My commission expires June 1, 1957

Notary Public. *Laurel Annan*

PLUGGING
FILE SEC 21 T 24 R 31 W
BOOK PAGE 28 LINE 4

RECEIVED
STATE CORPORATION COMMISSION
JAN 13 1956 1-13-56
CONSERVATION DIVISION
Wichita, Kansas

2 copies Betty

WELL LOG

15-055-10089-0000

COMPANY **P. KIRK JOHNSON**
FARM **Lee Kiser** NO. **1**


SEC. **21** T. **24** R. **31**
LOC. **SW SW SW**

TOTAL DEPTH **5120'**

COUNTY **Finney**

COMM. **December 4, 1955** COMP. **December 28, 1955**

CONTRACTOR **GARVEY DRILLING COMPANY**

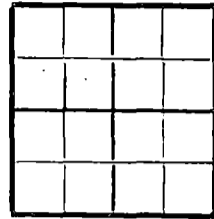


CASING **10-3/4" @ 582' w/750 sacks posmix, 2% CC**

ELEVATION **2910 D.F.**

PRODUCTION

FIGURES INDICATE BOTTOM OF FORMATIONS

| | |
|------|----------------------|
| 390 | Sand, Shale & Shells |
| 1100 | Shale |
| 1275 | Red Bed |
| 1530 | Red Bed & Shale |
| 1955 | Shale & Shells |
| 2120 | Shale |
| 2558 | Shale & Shells |
| 2825 | Shale & Lime |
| 2888 | Lime |
| 2980 | Lime & Shale |
| 3040 | Lime |
| 3212 | Lime & Shale |
| 3275 | Lime |
| 3720 | Lime & Shale |
| 3940 | Lime |
| 4010 | Lime & Shale |
| 4655 | Lime |
| 4699 | Lime & Shale |
| 4752 | Lime & Shale Streaks |
| 4770 | Lime |
| 4812 | Lime & Shale |
| 4875 | Lime |
| 4914 | Lime & Chert |
| 5120 | Lime |
| 5120 | T.D. |

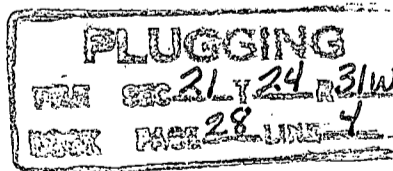

State of KANSAS
County of SEDWICK

SS :

I, Robert F. White of GARVEY DRILLING COMPANY

upon oath state that the above and foregoing is a true and correct copy of the log of the #1 Lee Kiser well

JAN 28 1956
CONSERVATION DIVISION

Robert F. White

Subscribed and sworn to before me this 10th day of January 19 55

My Commission Expires: August 8, 1959

Edward [Signature]
NOTARY PUBLIC