

WELL PLUGGING RECORD

Give All Information Completely
Make Required Affidavit
Mail or Deliver Report to:
Conservation Division
State Corporation Commission
211 No. Broadway
Wichita, Kansas

Finney County, Sec. 18 Twp. 24 Rge. (E) 31 (W)

Location as "NE/CNW/SW" or footage from lines CW/2

Lease Owner Kansas-Nebraska Natural Gas Company, Inc.

Lease Name Eichorn Well No. 1

Office Address 300 North St. Joseph Ave., Hastings, Nebraska

Character of Well (completed as Oil, Gas or Dry Hole) Gas

Date well completed July 5 1957

Application for plugging filed December 6 1968

Application for plugging approved December 9 1968


Plugging commenced December 20 1968

Plugging completed December 28 1968

Reason for abandonment of well or producing formation Depleted - water encroachment

If a producing well is abandoned, date of last production October 1967

Was permission obtained from the Conservation Division or its agents before plugging was commenced? Yes

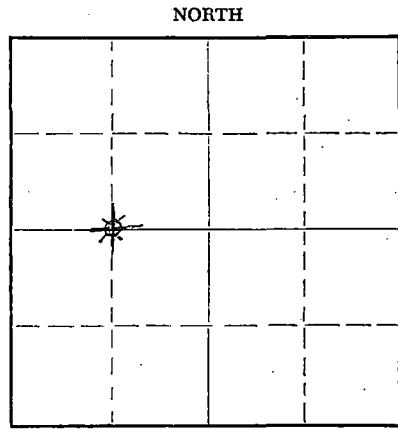

Locate well correctly on above Section Plat

Name of Conservation Agent who supervised plugging of this well Ed Eves

Producing formation Hugoton Pay Depth to top 2605 Bottom 2668 Total Depth of Well 2686 Feet

Show depth and thickness of all water, oil and gas formations.

OIL, GAS OR WATER RECORDS

CASING RECORD

FORMATION	CONTENT	FROM	TO	SIZE	PUT IN	PULLED OUT
Herrington	Gas	2605	2612	8-5/8"	372'	0
Upper Krider	Gas	2632	2648	5-1/2"	2683'	1429'
Lower Krider	Gas	2654	2668			

Describe in detail the manner in which the well was plugged, indicating where the mud fluid was placed and the method or methods used in introducing it into the hole. If cement or other plugs were used, state the character of same and depth placed, from _____ feet to _____ feet for each plug set.

Mixed 25 sks. cement and 1 sk. hulls and pumped plug to 2414 ft. Shot pipe free at 1423 ft. Pulled 1429 ft. of 5-1/2" casing. Ran 25 jts. 1-1/4" tubing. Mixed 5 sks. Gel and pumped to 500 ft. Mixed 50 sks. cement and pumped down 1-1/4" tubing at 400 ft., placing cement plug from 400 ft. to 250 ft. Mixed 10 sks. cement and pumped down tubing, placing cement plug from 40 ft. to surface.

RECEIVED
STATE CORPORATION COMMISSION
JAN 24 1969
CONSERVATION DIVISION
Wichita, Kansas

(If additional description is necessary, use BACK of this sheet)
Name of Plugging Contractor Sargent's Casing Pulling Service
Address Box 506 Liberal, Kansas

STATE OF NEBRASKA, COUNTY OF ADAMS, ss.
THOMAS C. SWANSON (employee of owner) or (owner or operator) of the above-described well, being first duly sworn on oath, says: That I have knowledge of the facts, statements, and matters herein contained and the log of the above-described well as filed and that the same are true and correct. So help me God.

(Signature) Thomas C. Swanson, Hon. Sec'y. Prod.
Box 608, Hastings, Neb., 68901
(Address)

SUBSCRIBED AND SWORN to before me this 22nd day of January, 1969

My commission expires January 23, 1970
F. S. WHITE Notary Public.

15-055-00825-0000

COMPANY - Kansas-Nebraska Natural Gas Co.

CONTRACTOR - Fees Drilling Company

FARM - Eichorn No. 1
LOC. - C/W/2
Sec. 18-24-31
Finney County,
Kansas

COMMENCED: 5-24-57
COMPLETED: 5-29-57

ELEVATION:

TOTAL DEPTH: 2686 ft.

PRODUCTION: Gas

CASING: 372' of 8 5/8", cem. w/200 sacks poz. mix
2682' of 5 1/2", cem. w/200 sacks poz. mix

FROM	TO	
0	310	sand - chalk
310	380	anhydrite & shale
380	892	shale & sand
892	1450	shale w/lime streaks
1450	1940	shale & lime
1940	2202	shale
2202	2293	shale
2293	2560	shale & anhydrite
2560	2687	shale & lime

RECEIVED
STATE CORPORATION COMMISSION
DEC 9 1968
CONSERVATION DIVISION
Wichita, Kansas