


STATE OF KANSAS
STATE CORPORATION COMMISSION

WELL PLUGGING RECORD

Give All Information Completely
Make Required Affidavit
Mail or Deliver Report to:
Conservation Division
State Corporation Commission
211 No. Broadway
Wichita, Kansas

Hodgeman County. Sec. 17 Twp. 24 Rge. (E) 24 (W)

Location as "NE/CNW/SW" or footage from lines C SE SW
Lease Owner Braden Drilling, Inc.
Lease Name Janssen Well No. 1
Office Address 1620 Wichita Plaza, Wichita, Kansas
Character of Well (completed as Oil, Gas or Dry Hole) Dry
Date well completed April 22 19 64
Application for plugging filed April 22 19 64
Application for plugging approved April 22 19 64
Plugging commenced April 22 19 64
Plugging completed April 22 19 64
Reason for abandonment of well or producing formation Dry

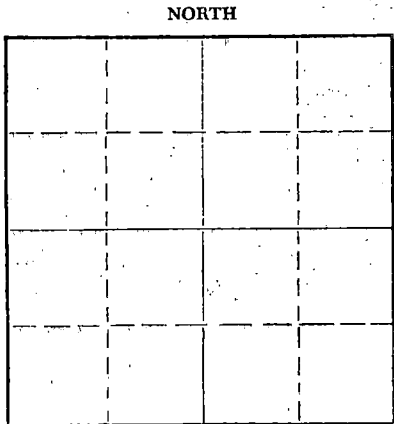

Locate well correctly on above Section Plat

If a producing well is abandoned, date of last production 19
Was permission obtained from the Conservation Division or its agents before plugging was commenced? Yes

Name of Conservation Agent who supervised plugging of this well Hugh E. Scott, Liberal, Kansas
Producing formation _____ Depth to top _____ Bottom _____ Total Depth of Well 4900 Feet
Show depth and thickness of all water, oil and gas formations.

OIL, GAS OR WATER RECORDS

CASING RECORD

FORMATION	CONTENT	FROM	TO	SIZE	PUT IN	PULLED OUT
		0	188	8 5/8	188	none

Describe in detail the manner in which the well was plugged, indicating where the mud fluid was placed and the method or methods used in introducing it into the hole. If cement or other plugs were used, state the character of same and depth placed, from _____ feet to _____ feet for each plug set.

Set plug at 650' and cemented with 25 sacks cement. Plug at 180' and cemented with 20 sacks cement. Filled hole with heavy mud. Plug at 40' and cemented with 15 sacks cement.

RECEIVED
STATE CORPORATION COMMISSION

APR 28 1964

CONSERVATION DIVISION
Wichita, Kansas

4-28-64

(If additional description is necessary, use BACK of this sheet)
Name of Plugging Contractor Braden Drilling, Inc.
Address 1620 Wichita Plaza, Wichita, Kansas

STATE OF Kansas, COUNTY OF Sedgwick, ss.
James Tasheff (employee of owner) or (owner or operator) of the above-described well, being first duly sworn on oath, says: That I have knowledge of the facts, statements, and matters herein contained and the log of the above-described well as filed and that the same are true and correct. So help me God.

(Signature) James Tasheff
1620 Wichita Plaza
(Address)

SUBSCRIBED AND SWORN TO before me this 24 day of April, 1964

My commission expires March 21, 1966
Hugh E. Scott
Notary Public.



DRILLER'S LOG

Braden Drilling, Inc.
 JANSSEN #1
 C SE/4 SW/4 Sec. 17-24S-24W
 Hodgeman County, Kansas

Commenced: April 10, 1964

Completed: April 22, 1964

Set 8-5/8" surface casing at 188'
 and cemented with 145 sacks cement.

<u>Formation</u>	<u>From</u>	<u>To</u>
Surface sand and shale	0	190
Shale	190	390
Blue-gray shale	390	700
Redbed	700	1101
Anhydrite	1101	1113
Redbed	1113	1180
Sand	1180	1270
Redbed	1270	1405
Shale	1405	1677
Shale and shells	1677	2070
Shale, shells, Lime	2070	2465
Shale	2465	2820
Lime and shale	2820	2920
Lime	2920	3057
Lime and shale	3057	3220
Lime	3220	3360
Lime and shale	3360	3485
Shale and chalky lime	3485	3790
Lime - chalky	3790	3865
Shale and chalky lime	3865	4128
Lime and shale	4128	4166
Lime	4166	4435
Lime and shale	4435	4575
Shaly lime	4575	4630
Shale and lime	4630	4810
Lime	4810	4823
Cherty lime	4823	4847
Lime and chert	4847	4880
Lime	4880	4900 T.D.

RECEIVED
 STATE CORPORATION COMMISSION


APR 28 1964

CONSERVATION DIVISION
 Wichita, Kansas

I hereby certify that this is a true and correct log of the above captioned well as shown by the daily drilling reports.


 James Tasheff

Subscribed and sworn to before me this 24th day of April, 1964.


 Helen Schultz, Notary Public

My commission expires March 21, 1966