

STATE OF KANSAS
STATE CORPORATION COMMISSION


Give All Information Completely
Make Required Affidavit
Mail or Deliver Report to:
Conservation Division
State Corporation Commission
800 Bitting Building
Wichita, Kansas

WELL PLUGGING RECORD

Hodgeman County, Sec. 21 Twp. 24 Rge. 24 (E) W (W)

Location as "NE/CNW 1/4 SW 1/4" or footage from lines NE NE NE
Lease Owner B & R Drilling, Inc.
Lease Name Doll Well No. 1
Office Address Russell, Kansas
Character of Well (completed as Oil, Gas or Dry Hole) Dry Hole
Date well completed August 2, 1951 19
Application for plugging filed August 1, 1951 Verbally 19
Application for plugging approved August 1, 1951 " 19
Plugging commenced August 1, 1951 19
Plugging completed August 2, 1951 19
Reason for abandonment of well or producing formation Dry Hole

NORTH

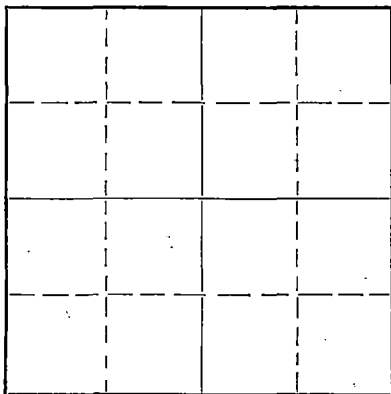

Locate well correctly on above
Section Plat

If a producing well is abandoned, date of last production 19
Was permission obtained from the Conservation Division or its agents before plugging was commenced? Yes

Name of Conservation Agent who supervised plugging of this well C. D. Stough
Producing formation Depth to top Bottom Total Depth of Well 4915' Feet
Show depth and thickness of all water, oil and gas formations.

OIL, GAS OR WATER RECORDS

CASING RECORD

Formation	Content	From	To	Size	Put In	Pulled Out
				8 5/8"	180'	None

Describe in detail the manner in which the well was plugged, indicating where the mud fluid was placed and the method or methods used in introducing it into the hole. If cement or other plugs were used, state the character of same and depth placed, from feet to feet for each plug set.

Plugging Record

Set first plug at 180'. Cemented with 15 sacks of cement thru drill pipe. Set second plug 35' and cemented with 10 sacks cement.

(If additional description is necessary, use BACK of this sheet)

Correspondence regarding this well should be addressed to B & R Drilling, Inc.
Address Russell, Kansas

STATE OF Kansas, COUNTY OF Russell, ss.
W. A. Michaelis, Jr. (employee of owner) or (owner or operator) of the above-described well,


being first duly sworn on oath, says: That I have knowledge of the facts, statements, and matters herein contained and the log of the above-described well as filed and that the same are true and correct. So help me God.

(Signature) W. A. Michaelis, Jr.
Russell, Kansas (Address)

SUBSCRIBED AND SWORN to before me this 17th day of August, 1951

My commission expires 6-17-54

23-3278-s 4-50-10M

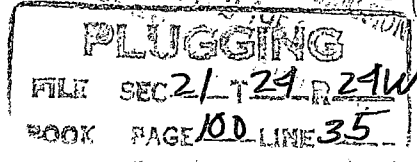

Notary Public.

8-22-51

B. A. R. Drilling, Inc.
Dell No. 1

NE NE NE of Section 21-24-24W
Hodgeman County, Kansas

Total Depth: 4915'
Comm: 7-6-51
Comp: 8-2-51

Casing

8 5/8" Set @ 180'

Cement

125 sack of Lehigh

Formation	Depth
Surface Hole	163
Shale	600
Sand-Shale	700
Sand	825
Shale	850
Shale-Sand	950
Shale-Shells	1070
Sand	1355
Sand-Shale	1579
Shale-Redbed-Shells	1765
Shells-Shale	2315
Lime-Shale	2320
Anhydrite-Shale	2430
Lime-Shale	3865
Lime	4010
Lime-Shale	4110
Lime	4165
Lime-Chert	4195
Lime	4640
Lime-Shale	4805
Lime-Chert	4815
Conglomerate-Cherty	4840
Lime-Chert	4862
Lime-Shale	4880
Lime	4915

STATE OF KANSAS)
)SS
RUSSELL COUNTY)

I hereby certify that the above information is true and correct to the best of my knowledge.

RECEIVED
CONSERVATION COMMISSION
AUG 22 1951
CONSERVATION DIVISION
Wichita, Kansas

Violet Keller

Subscribed and sworn to before me this 17th day of August, 1951

Clara Lumme
Notary Public

My commission expires: 6-17-54

PLUGGING
FILE SEC 21 T 24 R 24 W
BOOK PAGE 100 LINE 35