


STATE OF KANSAS  
STATE CORPORATION COMMISSION

WELL PLUGGING RECORD

Give All Information Completely  
Make Required Affidavit  
Mail or Deliver Report to:  
Conservation Division  
State Corporation Commission  
211 So. Broadway  
Wichita, Kansas

Hodgeman County. Sec. 23 Twp. 24S Rge. 24 (E) W (W)  
Location as "NE/CNW/SW" or footage from lines SW SW SW  
Lease Owner Aurora Gasoline Company, et al  
Lease Name Burr Well No. 1  
Office Address 1107 Union National Bank Bldg., Wichita, Kansas  
Character of Well (completed as Oil, Gas or Dry Hole) Dry Hole  
Date well completed March 14, 1957  
Application for plugging filed March 14, 1957  
Application for plugging approved " " 19 57  
Plugging commenced " " 19 57  
Plugging completed " " 1957  
Reason for abandonment of well or producing formation Dry Hole

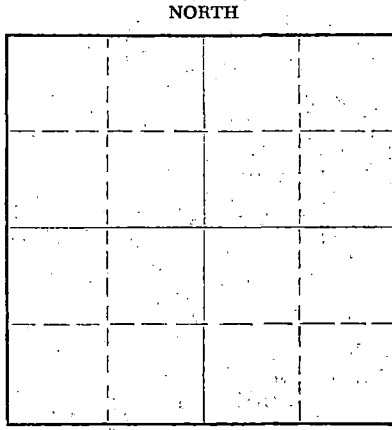

Locate well correctly on above  
Section Plat

If a producing well is abandoned, date of last production 19  
Was permission obtained from the Conservation Division or its agents before plugging was commenced? Yes

Name of Conservation Agent who supervised plugging of this well M. A. Rives, Box 8, Pratt, Kansas  
Producing formation \_\_\_\_\_ Depth to top \_\_\_\_\_ Bottom \_\_\_\_\_ Total Depth of Well 4970 Feet  
Show depth and thickness of all water, oil and gas formations.

OIL, GAS OR WATER RECORDS

CASING RECORD

FORMATION	CONTENT	FROM	TO	SIZE	PUT IN	PULLED OUT
Surface Hole	Water	0	245	8 5/8	240'	None
See attached log						

Describe in detail the manner in which the well was plugged, indicating where the mud fluid was placed and the method or methods used in introducing it into the hole. If cement or other plugs were used, state the character of same and depth placed, from \_\_\_\_\_ feet to \_\_\_\_\_ feet for each plug set.

Mud from 4970' to 240': Put 20 sacks cement on plug @ 240' through Drill Pipe.

Filled with mud to 35': Put 10 sacks cement on plug @ 35' to surface.

(If additional description is necessary, use BACK of this sheet)

Name of Plugging Contractor Rex & Morris Drilling Company  
Address Box 334, El Dorado, Kansas

STATE OF Kansas, COUNTY OF Butler, ss.  
\_\_\_\_\_, (employee of owner) or (owner or operator) of the above-described well, being first duly sworn on oath, says: That I have knowledge of the facts, statements, and matters herein contained and the log of the above-described well as filed and that the same are true and correct. So help me God.

(Signature) [Signature]  
Box 334, El Dorado, Kansas  
(Address)

SUBSCRIBED AND SWORN TO before me this 20th day of March, 19 57

My commission expires July 23, 1960

Winifred E. Cruik  
Notary Public.

PLUGGING  
FILE SEC. 23 T. 24 R. 24W  
BOOK PAGE 149 LINE 1

RECEIVED  
CONSERVATION COMMISSION  
MAR 21 1957  
CONSERVATION DIVISION  
Wichita, Kansas  
3-21-57

Elevation - 2486 DF  
2489 RB

BURR WELL # 1

AURORA GASOLINE COMPANY, ET AL

Total Depth - 4970  
Contractor - Rex & Morris Drilling Co.  
Commenced - 2-23-57  
Completed - 3-14-57  
Initial Production - D & A  
Location - SW SW SW  
Section 23-24S-24W  
Hodgeman County, Kansas.

Casing Record:  
8 5/8 @ 245' w/ 175 sacks

FORMATION	DEPTH
Surface Hole	245
Shale	750
Sand & Shale	850
Red Bed	1150
Sand & Shale	1335
Shale & Red Rock	1575
Shale	1645
Anhydrite	1670
Shale & Shells	1850
Shale & Lime	2030
Shale & Shells	2240
Lime & Shale	2650
Broken Lime	2730
Lime	2975
Lime & Shale	3158
Lime	3169
Lime & Shale	3429
Shale & Lime	3548
Lime & Shale	3712
Shale & Lime	3822
Lime	3977
Shale & Lime	4063
Lime	4612
Shale & Lime	4655
Lime	4695
Lime & Shale	4761
Lime (Miss @ 4833)	4970
Schlumberger	

I hereby certify the foregoing statements are true and correct to the best of my knowledge and belief.

Rex & Morris Drilling Company

By Paul D. Moore

Title \_\_\_\_\_

STATE OF KANSAS )  
                                  ) SS.  
COUNTY OF BUTLER )

Subscribed and sworn to before me, a Notary Public, this 20 day of March 1957

Winifred E. Cruitt  
Winifred E. Cruitt - Notary Public

My commission expires:  
July 23, 1960

PLUGGING  
FILE - SEC 23 T 24 R 24W  
BOOK - PAGE 149 LINE 1

