

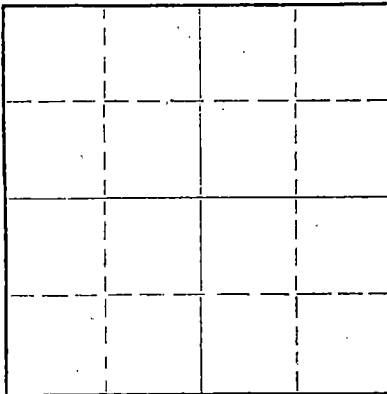
STATE OF KANSAS
STATE CORPORATION COMMISSION

Form CP-4

Give All Information Completely
Make Required Affidavit
Mail or Deliver Report to:
Conservation Division
State Corporation Commission
211 No. Broadway
Wichita, Kansas

WELL PLUGGING RECORD

NORTH

Locate well correctly on above
Section Plat

Hodgeman County, Sec. 34 Twp. 24S Rge. 24W(E) (W)
Location as "NE/CNW/SW" or footage from lines SW SW SE
Lease Owner Kenneth Rupp
Lease Name Royse Well No. 1
Office Address 427 Union Center, Wichita, Kansas
Character of Well (completed as Oil, Gas or Dry Hole) D&A
Date well completed October 5 19 63
Application for plugging filed October 5 19 63
Application for plugging approved October 5 19 63
Plugging commenced October 5 19 63
Plugging completed October 5 19 63
Reason for abandonment of well or producing formation D&A

If a producing well is abandoned, date of last production 19
Was permission obtained from the Conservation Division or its agents before plugging was commenced? Yes

Name of Conservation Agent who supervised plugging of this well Hugh Scott
Producing formation _____ Depth to top _____ Bottom _____ Total Depth of Well 4900 Feet
Show depth and thickness of all water, oil and gas formations.

OIL, GAS OR WATER RECORDS

CASING RECORD

FORMATION	CONTENT	FROM	TO	SIZE	PUT IN	PULLED OUT
				8 5/8"	286'	-0-

Describe in detail the manner in which the well was plugged, indicating where the mud fluid was placed and the method or methods used in introducing it into the hole. If cement or other plugs were used, state the character of same and depth placed, from _____ feet to _____ feet for each plug set.

Spot 25 sx. @ 744'
Spot 25 sx. @ 279'
15 sx @ 40' to top
of hole. Plug @ 40'

RECEIVED
STATE CORPORATION COMMISSION

OCT 11 1963

CONSERVATION DIVISION
Wichita, Kansas

10-11-1963

(If additional description is necessary, use BACK of this sheet)
Name of Plugging Contractor Red Tiger Drilling Co.
Address Box 173--Russell, Kansas

STATE OF KANSAS, COUNTY OF SEDGWICK, ss.

George A. Angle (owner or operator) of the above-described well, being first duly sworn on oath, says: That I have knowledge of the facts, statements, and matters herein contained and the log of the above-described well as filed and that the same are true and correct. So help me God.

(Signature)

George A. Angle
1720 Wichita Plaza, Wichita 2, Kansas
(Address)SUBSCRIBED AND SWORN TO before me this 8th day of October, 19 63My commission expires 11-17-66

Notary Public.

DRILLERS LOG

No. 1. Royse

CASING RECORD: COMPANY: Kenneth Rupp DESCRIPTION:
 8 5/8" @ 286' CONTRACTOR: Red Tiger Drilling Co. SW SW SE
 w/185 ex cement COMMENCED: September 22, 1963 34-24B-24W
 TOTAL DEPTH: 4900' COMPLETED: October 5, 1963 ELEVATION: 2467 DF
 2470 RB

<u>FORMATION</u>	<u>FROM</u>	<u>TO</u>	<u>REMARKS</u>
Sandy Clay	0	75	
Shale & Shells	75	287	
Shale Clay & Sand	287	312	
Sand	312	341	
Shale	341	608	
Sand	608	741	
Redbed & Shale	741	1073	
Sand	1073	1290	
Shale & Redbed	1290	1577	
Anhydrite	1577	1582	
Shale	1582	1611	
Hard Slate	1611	1635	
Shale & Shells	1635	2020	
Shale & Salt Streaks	2020	2367	
Shale & Lino	2367	4030	
Lime	4030	4510	
Lime & Shale	4510	4583	
Lime	4583	4636	
Lime & Shale	4636	4900	

RECEIVED
STATE CORPORATION COMMISSION

OCT 11 1963

CONSERVATION DIVISION
Wichita, Kansas

I certify that this is a true and correct copy of the above log to the best of my knowledge.

RED TIGER DRILLING COMPANY

George A. Angile
George A. Angile

Subscribed and sworn to before me this 8th day of October, 1963.

Mary V. Head
Notary Public

My Commission Expires:

11-17-66