


WELL PLUGGING RECORD

Give All Information Completely  
Make Required Affidavit  
Mail or Deliver Report to:  
Conservation Division  
State Corporation Commission  
211 No. Broadway  
Wichita, Kansas

NORTH

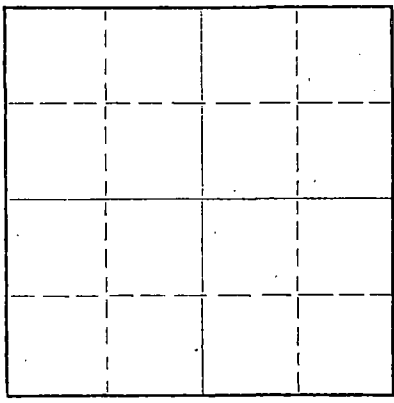

Locate well correctly on above Section Plat

Reno County. Sec. 11 Twp. 23 Rge. 10 (E) xx (W)  
Location as "NE/CNW/SW" or footage from lines SW NE SW  
Lease Owner Morgenstern & Specter  
Lease Name Tonn Well No. 9  
Office Address Russell, Kansas  
Character of Well (completed as Oil, Gas or Dry Hole) oil  
Date well completed 8-1-42 19  
Application for plugging filed March 16, 1959 19  
Application for plugging approved March 17, 1959 19  
Plugging commenced 6/3/59 19  
Plugging completed 6/11/59 19  
Reason for abandonment of well or producing formation failure to produce profitably  
If a producing well is abandoned, date of last production 19  
Was permission obtained from the Conservation Division or its agents before plugging was commenced? Yes

Name of Conservation Agent who supervised plugging of this well Fred W. Hampel  
Producing formation Viola Depth to top 3753 Bottom 3764 1/2 Total Depth of Well 3764 1/2 Feet  
Show depth and thickness of all water, oil and gas formations.

OIL, GAS OR WATER RECORDS				CASING RECORD		
FORMATION	CONTENT	FROM	TO	SIZE	PUT IN	PULLED OUT
				7"OD	3757 ft.	2922 ft.
				10 3/4"	291 ft.	none

Describe in detail the manner in which the well was plugged, indicating where the mud fluid was placed and the method or methods used in introducing it into the hole. If cement or other plugs were used, state the character of same and depth placed, from \_\_\_\_\_ feet to \_\_\_\_\_ feet for each plug set.

plugged to 3740 ft.. with sand and dumped 5 sacks cement. Mudded hole to 260 ft. and set 10 ft. rock bridge. Dumped 25 sacks cement. Mudded hole to 35 ft. and set rock bridge. Dumped 15 sacks cement.

RECEIVED  
STATE CORPORATION COMMISSION  
AUG 6 1959  
CONSERVATION DIVISION  
Wichita, Kansas

8-6-59

Name of Plugging Contractor E & L Casing Pulling Co.  
Address 1416 Coolidge, Great Bend, Kansas

STATE OF Kansas, COUNTY OF Russell, ss.  
Morgenstern & Specter (employee of owner) or (owner or operator) of the above-described well, being first duly sworn on oath, says: That I have knowledge of the facts, statements, and matters herein contained and the log of the above-described well as filed and that the same are true and correct. So help me God.

(Signature) [Signature]

SUBSCRIBED AND SWORN TO before me this 13th day of June, 1959

My commission expires Dec 1, 1959 Notary Public. [Signature]

PLUGGING  
FILE SEC. 11 T. 23 R. 10W  
BOOK PAGE 22 LINE 13

15-155-02189-0000


LEADER OIL CO.  
Tonn No. 9.

SEC. 11 T. 23 R. 10 W  
SW NE SW

CORRECTED LOG

Total Depth. 3764 1/2'  
Comm. 7-1-42 Comp. 8-1-42  
Shot or Treated.  
Contractor. Ruso Drlg. Co.  
Issued. 10-3-42 Rotary O-3757  
Cable 3757-64 1/2

County. Reno

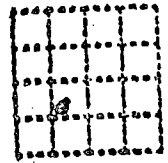

CASING:

10 3/4" 291' Cem.  
7" 3757' Com.

Elevation.

Production. Pot. 12,174 B.BHPB

Figures Indicate Bottom of Formations.

sand	60
shale & red bed	565
anhydrite	595
shale & shells	965
salt & shale	1160
shale & shells	1340
shale & lime	1550
lime sdy	1685
lime	1840
shale & lime	2610
lime	2970
shale	3030
lime	3220
shale	3305
lime	3585
chert & shale	3617
lime	3623
chert	3638
shale	3750
lime Misener	3753
lime Viola	3764 1/2
Total Depth.	

7" csg 3757 Com., drld TD  
3764 1/2, Hole filled 3000'  
over 400' wtr in one hr &  
30 min. Acidized w/500 G. 7-31-42  
Flowed 55 bbl thru 1" choke,  
27 bbl 3/4" choke, 24 bbls  
1/2" choke, 13 1/2 bbl 3/8" choke  
Btm Hole pressure bomb Pot.  
12,174 bbls.

3763 1/2-64 1/2 hole filled 3000' over  
400' wtr 1 hr & 30 min.

Top Viola 3753  
Pay 3763 1/2-64 1/2

RECEIVED  
STATE CORPORATION COMMISSION

MAR 16 1959

CONSERVATION DIVISION  
Wichita, Kansas

PLUGGING  
FILE - SEC 11 T 23 R 10 W  
BOOK PAGE 22 LINE 13