

# WELL PLUGGING RECORD


STATE OF KANSAS  
STATE CORPORATION COMMISSION

Give All Information Completely  
Make Required Affidavit  
Mail or Deliver Report to:  
Conservation Division  
State Corporation Commission  
800 Bittling Building  
Wichita, Kansas

## OR FORMATION PLUGGING RECORD

Strike out upper line  
when reporting plug-  
ging of formations.

Reno County. Sec. 11 Twp. 23 Rge. (E) 16 (W)  
 Location as "NE $\frac{1}{4}$ NW $\frac{1}{4}$ SW $\frac{1}{4}$ " or footage from lines. South Half  
 Lease Owner. Carter Oil Company  
 Lease Name. A. Tonn Well No. 7  
 Office Address. Tulsa, Oklahoma  
 Character of Well (completed as Oil, Gas or Dry Hole). Oil  
 Date well completed. 6-2 19 42  
 Application for plugging filed. 12-3 19 47  
 Application for plugging approved. 12-19 19 47  
 Plugging commenced. 2-2 19 48  
 Plugging completed. 3-17 19 48  
 Reason for abandonment of well or producing formation. Unprofitable for operation

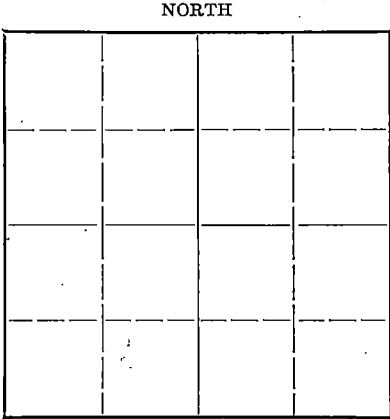

Locate well correctly on above Section Plat

If a producing well is abandoned, date of last production. November 11, 19 47  
 Was permission obtained from the Conservation Division or its agents before plugging was commenced? Yes

Name of Conservation Agent who supervised plugging of this well. Ruell Durkee  
 Producing formation. Viola Lime Depth to top. 3745' Bottom. 3755' Total Depth of Well. 3755' Feet  
 Show depth and thickness of all water, oil and gas formations.

### OIL, GAS OR WATER RECORDS


### CASING RECORD

Formation	Content	From	To	Size	Put In	Pulled Out
Viola Lime	Oil	3745'	3755'	10 3/4"	288'	None
				7"	3760'	3065'

Describe in detail the manner in which the well was plugged, indicating where the mud fluid was placed and the method or methods used in introducing it into the hold. If cement or other plugs were used, state the character of same and depth placed, from \_\_\_\_\_ feet to \_\_\_\_\_ feet for each plug set.

Dumped 6 sacks of cement at 3745', cement filled to 3715'.  
 Shot pipe loose at 3061'. Pulled pipe, mudded hole from  
 3715' to 285'. Dumped 25 sacks of cement from 285', filled  
 up to 235'. Finished filling surface pipe with mud from 235'  
 to 10' of top of surface and finished with 8 sacks of cement  
 at top of surface.

6-22-48

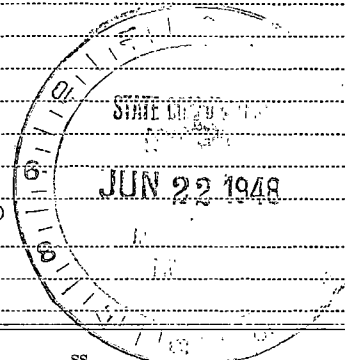

(If additional description is necessary, use BACK of this sheet)

Correspondence regarding this well should be addressed to \_\_\_\_\_  
 Address \_\_\_\_\_


STATE OF Kansas, COUNTY OF Barton, ss.  
 W. D. Maxwell (employee of owner) or (owner or operator) of the above-described well,  
 being first duly sworn on oath, says: That I have knowledge of the facts, statements, and matters herein contained and the log of the above-described well as filed and that the same are true and correct. So help me God.

(Signature) W. D. Maxwell Dist. Supt.  
Box 786 - Great Bend, Kans  
 (Address)

SUBSCRIBED AND SWORN to before me this 18 day of June, 1948

My Commission Expires July 29, 1950

My commission expires \_\_\_\_\_

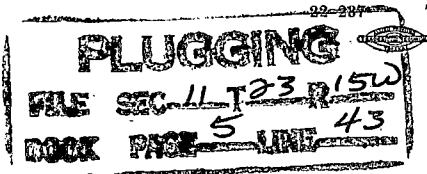

Well Record

A. Tonn, Well #7 S  $\frac{1}{2}$ -23S-16W, Reno County, Kansas

Formation	Bottom	Remarks
Sand	47	
Sand & shells	300	10 3/4" OB 3 ga. Spiral Weld csg cmtd.
Shale & shells	665	285' w/120 sacks
Red Bed	755	
Anhydrite	800	
Shale and shells	1175	
Lime	1530	
Lime & shale	1725	
Lime	1754	
Shale & lime	1885	
Shale	1955	
Shale & lime	2145	
Lime	2175	
Shale & lime	2705	
Shale	2785	
Lime	2915	
Shale	2960	
Lime	3075	
Shale	3100	
Lime	3170	
Lime & shale	3190	
Shale	3265	Top KC lime 3250'
Lime	3285	
Lime & shale	3335	
Lime	3599	
Chert & shale	3618	
Shale	3745	
Viola Lime	3755 $\frac{1}{2}$	Top Viola lime 3745' 7" OD smls csg cmtd 3750' w/100 sx bulk mixed 2% Aquajel w/plug to 372'. Loaded hole w/1100' water drilled to TD 3755' top pay 3755' hole filled 1400' with oil under 1100' water load in 8 hrs and 40 minutes. acidized w/500 gal pressure 650# drop to 200#, well flowed 59 bbl oil 1st hr. wide open; 43 bbl on 3/4" choke; 21 bbl on 1/2" choke; 16 bbl on 3/8" choke, bottom hole pressure bomb potential 28,755, bottom hole pres. high rate 1025#, low rate 1045#.

**PLUGGING**  
 FILE SEC 11 T23 R15W  
 BOOK PAGE 5 LINE 43

DEC 19 1947

Faint, mostly illegible text in the upper right quadrant of the page.

Vertical column of faint text on the left side of the page.

Vertical column of faint text in the center of the page.

23 1947

Faint text at the bottom right of the page.

Record of Formations

SW SE SE A. Tonn #7, S<sup>1</sup>/<sub>2</sub> 11-23S-10W, Reno County, Ks.

15-155-02187-0000

Formation	Bottom	Remarks
Sand	47	
Sand & shells	300	10 3/4" OD 3 Ga. Spiral Weld csg. cmtd.
Shale & shells	665	285' w/120 sacks.
Red Bed	755	
Anhydrite	800	
Shale & shells	1175	
Lime	1530	
Lime & shale	1725	
Lime	1745	
Shale & lime	1885	
Shale	1955	
Shale & lime	2145	
Lime	2175	
Shale & shells	2235	
Shale & lime	2705	
Shale	2785	
Lime	2915	
Shale	2960	
Lime	3075	
Shale	3100	
Lime	3170	
Lime & shale	3190	
Shale	3265	Top K6 Lime 3250'
Lime	3285	
Lime & shale	3335	
Lime	3599	
Chert & shale	3618	
Shale	3745	
Viola Lime	3755 <sup>1</sup> / <sub>2</sub>	Top Viola, lime 3745', 7" OD smls csg cmtd 3750' w/100 sx. bulk mixed 2% Aquajel w/plug to 3722! Loaded hole w/1100' water drilled to TD 3755 <sup>1</sup> / <sub>2</sub> '.