


STATE OF KANSAS  
STATE CORPORATION COMMISSION

WELL PLUGGING RECORD

Give All Information Completely  
Make Required Affidavit  
Mail or Deliver Report to:  
Conservation Division  
State Corporation Commission  
211 No. Broadway  
Wichita, Kansas

Reno County, Sec. 11 Twp. 23S Rge. 10 (E) (W)  
Location as "NE/CNW/SW" or footage from lines SW SE SW

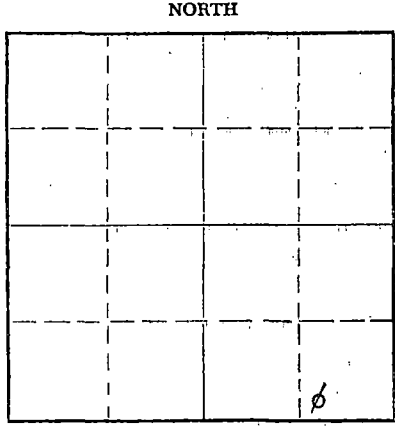

Lease Owner Morgenstern & Specter  
Lease Name Tonn Well No. 3  
Office Address Russell, Kansas  
Character of Well (completed as Oil, Gas or Dry Hole) Oil Well  
Date well completed February 10, 19 42  
Application for plugging filed March 16, 19 59  
Application for plugging approved March 17, 19 59  
Plugging commenced April 3, 19 59  
Plugging completed April 10, 19 59  
Reason for abandonment of well or producing formation Oil Depleted

If a producing well is abandoned, date of last production \_\_\_\_\_ 19\_\_\_\_  
Was permission obtained from the Conservation Division or its agents before plugging was commenced? Yes

Name of Conservation Agent who supervised plugging of this well Fred W. Hampel  
Producing formation \_\_\_\_\_ Depth to top \_\_\_\_\_ Bottom \_\_\_\_\_ Total Depth of Well 3764 1/2 Feet  
Show depth and thickness of all water, oil and gas formations.

OIL, GAS OR WATER RECORDS

CASING RECORD

FORMATION	CONTENT	FROM	TO	SIZE	PUT IN	PULLED OUT
				10-3/4"	287	None
				7"	3758	

Describe in detail the manner in which the well was plugged, indicating where the mud fluid was placed and the method or methods used in introducing it into the hole. If cement or other plugs were used, state the character of same and depth placed, from \_\_\_\_\_ feet to \_\_\_\_\_ feet for each plug set.

Filled hole with sand to 3740 feet and added 5 sacks of cement with dump bailer. Mudded hole to 280 feet and set 10 foot rock bridge and 25 sax of cement. Mudded hole to 30 feet and set 30 foot rock bridge with 15 sax of cement to surface.

8-5-63

RECEIVED  
STATE CORPORATION COMMISSION

AUG 13 1963

CONSERVATION DIVISION  
Wichita, Kansas

RECEIVED  
STATE CORPORATION COMMISSION

AUG 5 1963

CONSERVATION DIVISION  
Wichita, Kansas

(If additional description is necessary, use BACK of this sheet)

Name of Plugging Contractor Forbes Casing Pulling Company  
Address Great Bend, Kansas

STATE OF KANSAS, COUNTY OF SEDGWICK, ss.  
Arthur Morgenstern, (~~employee of owner~~) or (owner or operator) of the above-described well, being first duly sworn on oath, says: That I have knowledge of the facts, statements, and matters herein contained and the log of the above-described well as filed and that the same are true and correct. So help me God.

(Signature) Arthur Morgenstern  
511 Union National Bldg.  
(Address)

SUBSCRIBED AND SWORN TO before me this 13th day of August, 1963

My commission expires Sept. 26, 1965


Doris E. Steg  
Notary Public.

LEADER OIL COMPANY.  
 Tenn No. 3.

SEC. 11 T. 23 R. 10 W.  
 SW SE SW  
 330' f SL 1550' f WL SW $\frac{1}{4}$

Total Depth. 3764 $\frac{1}{2}$   
 Comm. 1-16-42 Comp. 2-10-42  
 Shot or Treated.  
 Contractor, Mercury Drilling Co.  
 Issued. 4-4-42

County Reno.

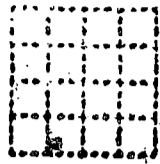

CASING. Rotary Cable 3761  
 3764 $\frac{1}{2}$

103/4" 287' cemented.  
 7" 3758' cemented.

Elevation.

Production. Pot. 3000 B.

Figures Indicate Bottom of Formations.

sand	65
shale and shells	327
shale and red bed	815
shells anhydrite & shale	830
shale and shells	1050
shale	1325
anhydrite	1490
shale and lime	1555
lime	1630
lime and shale	1725
sdv lime	1760
broken lime	1785
lime and shale	1825
broken lime	2085
shale	2132
broken lime	2192
shale and shells	2520
lime	2562
lime and shale	2645
lime	2731
broken lime and shale	2790
lime	3177
shale and shells	3225
lime	3241
lime and shale	3299
lime	3580
shale and lime	3609
lime	3665
shale and cherty lime	3703
shale and lime	3728
shale	3754
sand Misener	3756
chert	3758
Viola	3764 $\frac{1}{2}$
Total Depth.	

Drilled shoes 3758', hole filled 1800' in 40 minutes 3759-62, to 3165' in 5 $\frac{1}{2}$  hours after drilling shoes. Hole loaded with 1250' water. Well started flowing after drilling to TD. Started to run tubing. well started to flow, killed well with Halliburton, acidized with 500 gal, potential 3000 bbls no water. Flowed 70 bbls per hr thro 3/4 and 1/2" choke on pretest.

TOPS

Topeka 2790

Kansas City 3286

Viola

3757 (Corrected to Cable tools) Hole filled 1800' in 40 min. from 3759-62' to 3165' 5 $\frac{1}{2}$  hrs.

RECEIVED  
 STATE CORPORATION COMM

MAR 16 1959

CONSERVATION DIVISION  
 Wichita, Kansas

PLUGGING  
 FILE SEC 11 T 23 R 10 W  
 BOOK PAGE 22 LINE 9