

CARD MUST BE TYPED

State of Kansas
NOTICE OF INTENTION TO DRILL
(see rules on reverse side)

CARD MUST BE SIGNED

Starting Date: 11-10-84
month day year

API Number 15- 095-21,500-0000

OPERATOR: License # 9869
CHAPMAN ENERGY OKLAHOMA, INC.
Name
Address 120 SOUTH MARKET SUITE 320
City/State/Zip WICHITA, KS 67202
Contact Person DAVID CARGO
Phone 316-262-1191

SW-SW-SE. Sec. 16 Twp. 30 S, Rge. 7 East
..... West
(location)
..... 330 Ft North from Southeast Corner of Section
..... 2310 Ft West from Southeast Corner of Section
(Note: Locate well on Section Plat on reverse side)

CONTRACTOR: License # 5149
Name WHEATSTATE OILFIELD SERVICES, INC.
City/State PRATT, KS

Nearest lease or unit boundary line 330 feet.
County KINGMAN
Lease Name SIMON Well# 1
Domestic well within 330 feet: yes no
Municipal well within one mile: yes no

Well Drilled For: Well Class: Type Equipment:
 Oil Swd Infield Mud Rotary
 Gas Inj Pool Ext. Air Rotary
 OWWO Expl Wildcat Cable

Depth to Bottom of fresh water 1.00 feet
Lowest usable water formation Harper Sandstone
Depth to Bottom of usable water 200 feet
Surface pipe by Alternate: 1 2
Surface pipe to be set 250 feet
Conductor pipe if any required NA feet
Ground surface elevation NA feet MSL
This Authorization Expires 5-5-85
Approved By 11-5-84 *[Signature]*

If OWWO: old well info as follows:
Operator
Well Name
Comp Date Old Total Depth
Projected Total Depth 4400 feet
Projected Formation at TD MISSISSIPPIAN
Expected Producing Formations MISSISSIPPIAN

I certify that we will comply with K.S.A. 55-101, et seq., plus eventually plugging hole to K.C.C. specifications.

Date Nov. 5 1984 Signature of Operator or Agent *[Signature]*

[Signature] Title Geologist


NOV 05 1984

Must be filed with the K.C.C. five (5) days prior to commencing well
 This card void if drilling not started within six (6) months of date received by K.C.C.

Wichita, Kansas

11-5-84

A Regular Section of Land
 1 Mile = 5,280 Ft.

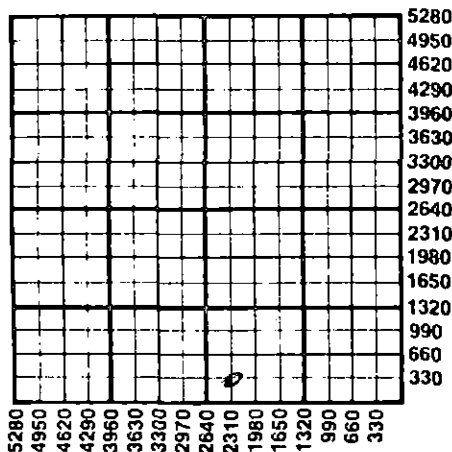

Important procedures to follow:

1. Notify District office before setting surface casing.
2. Set surface casing by circulating cement to the top.
3. File completion forms ACO-1 with K.C.C. within 90 days of well completion, following instructions on ACO-1, side 1, and including copies of wireline logs.
4. Notify District office 48 hours prior to old well workover or re-entry.
5. Prior to plugging, prepare a plugging plan, then obtain agreement from the appropriate district office for an approved plugging plan.
6. Submit plugging report (CP-4) to K.C.C. after plugging is completed.
7. Obtain an approved injection docket number before disposing of salt water.
8. Notify K.C.C. within 10 days when injection commences or terminates.
9. If an alternate 2 completion, cement in the production pipe from below any usable water to surface within 120 days of spud date.

State Corporation Commission of Kansas
 Conservation Division
 200 Colorado Derby Building
 Wichita, Kansas 67202
 (316) 263-3238