State of Kansas

CARD MUST BE SIGNED

NOTICE OF INTENTION TO DRILL

	mor	nth day	year		East
OPERATOR: License #5399				.C. SE SE Sec. 31. Twp. 30 s,	
Name American Energies Corporation				. 660 Ft. from South Line of Section	
Address 155 N. Market, Suite 710				600 Ft. from East Line of Section	
City/State/Zip Wichita, KS 67202				(Note: Locate well on Section Plat on reverse side)	
Contact Person. Alan L. DeGood				Nearest lease or unit boundary line	
Phone 316-263-5785				County Kingman	
CONTRACTOR: License #5418				Lease NameKU	
Name Allen Drilling Company				Ground surface elevation	
City/State Great Bend, KS				Domestic well within 330 feet:	yes X_no
Well Drilled For: Well Class: Type Equipment:				Municipal well within one mile:	ves Xno
± =	Storage	Infield	X Mud Rotary	Depth to bottom of fresh water 125! Depth to bottom of usable water 125!	
			Air Rotary	Depth to bottom of usable water 125723	<i>:0</i> ′
	_	Wildcat	•		1 X_ 2
If OWWO: old well info as follows:				Surface pipe planned to be set250!	
Operator				Conductor pipe required N/A	
Well Name				Projected Total Depth4, 800feet	
Comp Date Old Total Depth				Formation Simpson	
I certify that well will comply with K.S.A. 55-101, et seq., plus eventually plugging hole to KCC specifications.					
Date 12-2-88 Signature of Operator or Agent Www. L. Dellow Title Vice-President					
For KCC Use: Conductor Pipe I This Authorization	Required	6-5-89 feet;	Minimum Surface Pip	pe Required 250 Approved By LKM 12-5-88	, feet per Alt.
		-10-88-			

Must be filed with the K.C.C. five (5) days prior to commencing well This card void if drilling not started within six (6) months of date received by K.C.C.

Important procedures to follow:


- I. Notify District office before setting surface casing.
- 2. Set surface casing by circulating cement to the top.
- 3. File completion forms ACO-1 with K.C.C. within 120 days of well spud date, following instructions on ACO-1, side 1, and including copies of wireline logs.
- 4. Notify District office 48 hours prior to old well workover or re-entry.
- Prior to filing Intent, prepare a proposed plugging plan in case well is D & A, then obtain approval of plan when calling district office prior to setting surface pipe.
- 6. Submit plugging report (CP-4) to K.C.C. after plugging is completed.
- water.


 8. Notify K.C.C. within 10 days when injection commences or termi-


7. Obtain an approved injection docket number before disposing of salt

200 Colorado Derby Building

Wichita, Kansas 67202-1212 (316) 263-3238

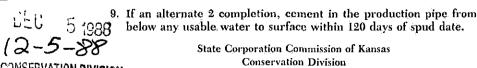

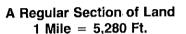

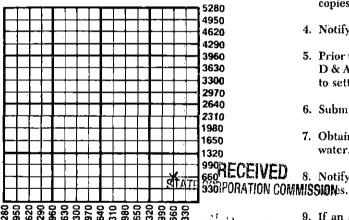

CONSERVATION DIVISION Wichita, Kansas