

$$\begin{array}{r} 85 \\ 30 \\ \hline 115 \end{array}$$


# PLAT OF ACREAGE ATTRIBUTABLE TO A WELL

State Corporation Commission, Conservation Division  
200 Colorado Derby Bldg. Wichita, Kansas 67202

OPERATOR Molz Oil Company LOCATION OF WELL:  
LEASE Lechner 1540 feet north of SE corner  
WELL NUMBER 2 770 feet west of SE corner  
FIELD Maple Grove Sec. 25 T 30 R 7 E/W  
COUNTY Kingman  
NO. OF ACRES ATTRIBUTABLE TO WELL 80 IS SECTION X REGULAR IRREGULAR?  
DESCRIPTION OF ACREAGE C NE SE IF IRREGULAR, LOCATE WELL FROM NEAREST  
CORNER BOUNDARY.

NOTE: If plat depicted is insufficient for your circumstances, you may attach your own scaled or surveyed plat.

## PLAT

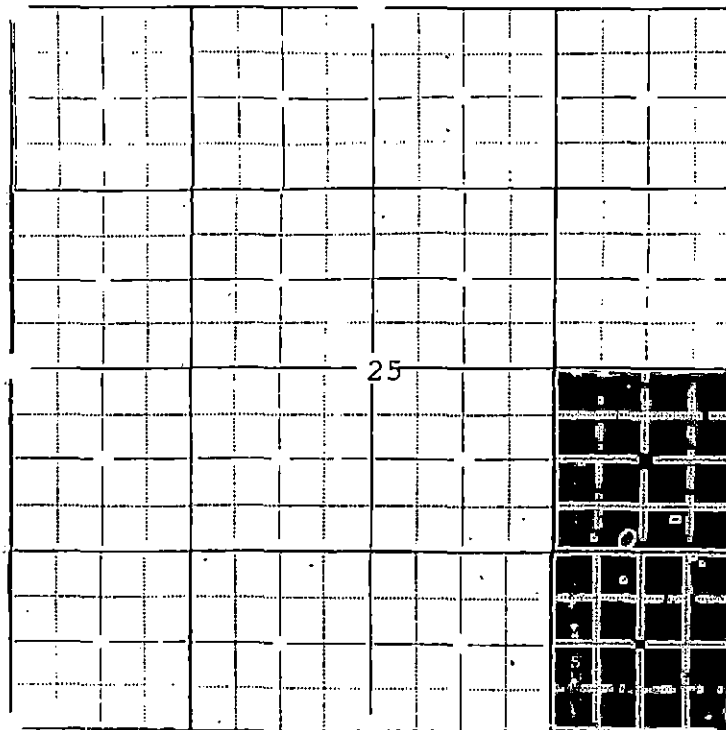

In plotting the proposed location of the well, you must show:

- 1) The manner in which you are using the depicted plat by identifying section lines, i.e. 1 section, 1 section with 8 surrounding partial sections, 4 sections, 16 sections, etc.;
- 2) the well's location relative to the location of other wells producing from the same common source of supply in adjoining drilling units, pursuant to K.A.R. 82-3-108, 82-3-207, 82-3-312, or special orders of the Commission;
- 3) the distance of the proposed drilling location from the section's east and south lines; and
- 4) the distance to the nearest lease or unit boundary line.

I hereby certify that the statements made herein are true and to the best of my knowledge and belief.

Signature of Operator or Agent [Signature]  
Date 4-29-91 Title President