

CARD MUST BE TYPED

State of Kansas
NOTICE OF INTENTION TO DRILL
 (see rules on reverse side)

CARD MUST BE SIGNED

Starting Date: 8 7 85
 month day year

OPERATOR: License # 5476
 Name DNB Drilling, Inc.
 Address 535 N. Oliver
 City/State/Zip Wichita, KS 67208
 Contact Person James Donelson Jr.
 Phone (316) 687-5471
 CONTRACTOR: License # 5123
 Name Pickrell Drilling Company
 City/State Wichita, KS

Well Drilled For:	Well Class:	Type Equipment:
☒ Oil ☐ Swd ☒ Infield ☒ Mud Rotary		
☐ Gas ☐ Inj ☐ Pool Ext. ☐ Air Rotary		
☒ OWWO ☐ Expl ☐ Wildcat ☐ Cable		

If OWWO: old well info as follows:

Operator ALPAR Resources, Inc.
 Well Name Norris #1
 Comp Date 3/7/72 Old Total Depth 4376
 Projected Total Depth 4760 feet
 Projected Formation at TD Simpson
 Expected Producing Formations Mississippi

I certify that we will comply with K.S.A. 55-101, et seq., plus eventually plugging hole to K.C.C. specifications.

Date 8-5-85 Signature of Operator or Agent

Title

API Number 15- 095-20, 271-2001
 SW NE SE Sec. 33 Twp 30 S, Rge 7
 (location)

1650 Ft North from Southeast Corner of Section
 990 Ft West from Southeast Corner of Section
 (Note: Locate well on Section Plat on reverse side)

Nearest lease or unit boundary line 990' feet
 County Kingman
 Lease Name Norris Well# 1

Domestic well within 330 feet: ☐ yes ☒ no
 Municipal well within one mile: ☐ yes ☒ no

Depth to Bottom of fresh water 120' feet
 Lowest usable water formation Ninnescah
 Depth to Bottom of usable water 250' feet
 Surface pipe by Alternate: 1 ☒ 2 ☐
 Surface pipe to be set 272' already there feet
 Conductor pipe if any required feet
 Ground surface elevation 1620 feet MSL
 This Authorization Expires 2-5-86
 Approved By 8-5-85


Date 8-5-85 Signature of Operator or Agent Title Office Manager

RECEIVED
STATE CORPORATION COMMISSION

AUG 5 1985
8-5-85
CONSERVATION DIVISION
Wichita, Kansas

Must be filed with the K.C.C. five (5) days prior to commencing well
This card void if drilling not started within six (6) months of date received by K.C.C.

A Regular Section of Land
1 Mile = 5,280 Ft.

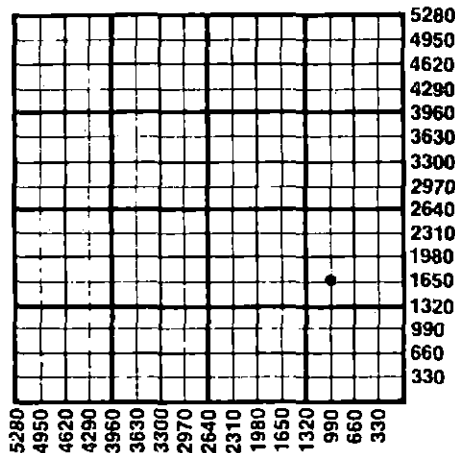

Important procedures to follow :

1. Notify District office before setting surface casing.
2. Set surface casing by circulating cement to the top.
3. File completion forms ACO-1 with K.C.C. within 90 days of well completion, following instructions on ACO-1, side 1, and including copies of wireline logs.
4. Notify District office 48 hours prior to old well workover or re-entry.
5. Prior to plugging, prepare a plugging plan, then obtain agreement from the appropriate district office for an approved plugging plan.
6. Submit plugging report (CP-4) to K.C.C. after plugging is completed.
7. Obtain an approved injection docket number before disposing of salt water.
8. Notify K.C.C. within 10 days when injection commences or terminates.
9. If an alternate 2 completion, cement in the production pipe from below any usable water to surface within 120 days of spud date.

State Corporation Commission of Kansas
Conservation Division
200 Colorado Derby Building
Wichita, Kansas 67202
(316) 263-3238