

CARD MUST BE TYPED

State of Kansas
NOTICE OF INTENTION TO DRILL
(see rules on reverse side)

CORRECTION
CARD MUST BE SIGNED
11-20-84

Starting Date: 11-14-84
month day year

API Number 15- ~~097~~ -21,501-0000
095

OPERATOR: License # 5123
Name Pickrell Drilling Company
Address 110 N. Market, Suite 205
City/State/Zip Wichita, Kansas 67202
Contact Person Jay McNeil
Phone (316)262-8427

*20' N C W/2 SE NW (location) Sec 11 Twp 30 S, Rge 7 East West

2990 Ft North from Southeast Corner of Section
* 3630 Ft West from Southeast Corner of Section
(Note: Locate well on Section Plat on reverse side)

CONTRACTOR: License # 5123
Name Pickrell Drilling Company
City/State Wichita, Kansas

Nearest lease or unit boundary line 330 feet.
County Kingman
Lease Name Muller 'B' Well# 1

Well Drilled For: **Well Class:** **Type Equipment:**
 Oil Swd Infield Mud Rotary
 Gas Inj Pool Ext. Air Rotary
 OWWO Expl Wildcat Cable

Domestic well within 330 feet : yes no
Municipal well within one mile : yes no

If OWWO: old well info as follows:

Operator
Well Name
Comp Date Old Total Depth
Projected Total Depth 4250 feet
Projected Formation at TD Mississippian
Expected Producing Formations Mississippian

Depth to Bottom of fresh water 60 feet
Lowest usable water formation Harper Silt
Depth to Bottom of usable water feet
Surface pipe by Alternate : 1 2
Surface pipe to be set 200+ feet
Conductor pipe if any required feet
Ground surface elevation 1454 feet MSL
This Authorization Expires 5-8-85
Approved By 11-8-84

I certify that we will comply with K.S.A. 55-101, et seq., plus eventually plugging hole to K.C.C. specifications. *X was C W/2 SE NW*


Date 11-15-84 Signature of Operator or Agent *Jay McNeil* Title Geologist 3300 FEL

*NOTE: Correction on location and footage.

Must be filed with the K.C.C. five (5) days prior to commencing well
This card void if drilling not started within six (6) months of date received by K.C.C.

Important procedures to follow:

**A Regular Section of Land
1 Mile = 5,280 Ft.**

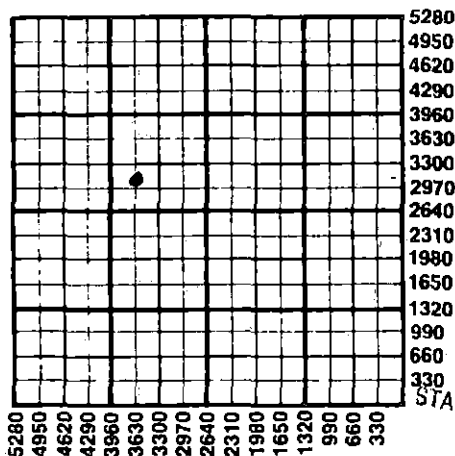

1. Notify District office before setting surface casing.
2. Set surface casing by circulating cement to the top.
3. File completion forms ACO-1 with K.C.C. within 90 days of well completion, following instructions on ACO-1, side 1, and including copies of wireline logs.
4. Notify District office 48 hours prior to old well workover or re-entry.
5. Prior to plugging, prepare a plugging plan, then obtain agreement from the appropriate district office for an approved plugging plan.
6. Submit plugging report (CP-4) to K.C.C. after plugging is completed.
7. Obtain an approved injection docket number before disposing of salt water.
8. Notify K.C.C. within 10 days when injection commences or terminates.
9. If an alternate 2 completion, cement in the production pipe from below any usable water to surface within 120 days of spud date.

RECEIVED
STATE CORPORATION COMMISSION

11-16-84
NOV 16 1984

CONSERVATION DIVISION
Wichita, Kansas

State Corporation Commission of Kansas
Conservation Division
200 Colorado Derby Building
Wichita, Kansas 67202
(316) 263-3238