

CARD MUST BE TYPED

State of Kansas
NOTICE OF INTENTION TO DRILL
(see rules on reverse side)

CARD MUST BE SIGNED

Starting Date: December 12, 1984
month day year

API Number 15- 095-21,510-000

OPERATOR: License # 5003
Name McCoy Petroleum Corporation
Address 500 Heritage Park Place
City/State/Zip Wichita, Kansas 67202
Contact Person John Roger McCoy
Phone 316-265-9697

C... SW... SW Sec 10 Twp 30 S, Rge 7
(location) East West

660 Ft North from Southeast Corner of Section
4620 Ft West from Southeast Corner of Section
(Note: Locate well on Section Plat on reverse side)

CONTRACTOR: License # 5658
Name Sweetman Drilling, Inc
City/State Wichita, Kansas 67202

Nearest lease or unit boundary line 660 feet
County Kingman
Lease Name Galchrist Well# 1

Well Drilled For: Well Class: Type Equipment:
 Oil Swd Infield Mud Rotary
 Gas Inj Pool Ext. Air Rotary
 OWWO Expl Wildcat Cable

Domestic well within 330 feet: yes no
Municipal well within one mile: yes no

If OWWO: old well info as follows:

Operator
Well Name
Comp Date Old Total Depth
Projected Total Depth 4200 feet
Projected Formation at TD Mississippian
Expected Producing Formations Mississippian

Depth to Bottom of fresh water 200 feet
Lowest usable water formation Seep water in Leonardian
Depth to Bottom of usable water 200 feet
Surface pipe by Alternate: 1 2
Surface pipe to be set 250 feet
Conductor pipe if any required None feet
Ground surface elevation 1430 (Estimate) feet MSL
This Authorization Expires 6-10-85
Approved By 12-10-84

I certify that we will comply with K.S.A. 55-101, et seq., plus eventually plugging hole to K.C.C. specifications.

Date 12-7-84 Signature of Operator or Agent

John Roger McCoy
Title President
MHC/KOHE 12/10/84

Must be filed with the K.C.C. five (5) days prior to commencing well
This card void if drilling not started within six (6) months of date received by K.C.C.

RECEIVED
STATE CORPORATION COMMISSION


12-10-84
DEC 10 1984

Important procedures to follow:

A Regular Section of Land
1 Mile = 5,280 Ft.

CONSERVATION DIVISION
Wichita, Kansas

1. Notify District office before setting surface casing.
2. Set surface casing by circulating cement to the top.
3. File completion forms ACO-1 with K.C.C. within 90 days of well completion, following instructions on ACO-1, side 1, and including copies of wireline logs.
4. Notify District office 48 hours prior to old well workover or re-entry.
5. Prior to plugging, prepare a plugging plan, then obtain agreement from the appropriate district office for an approved plugging plan.
6. Submit plugging report (CP-4) to K.C.C. after plugging is completed.
7. Obtain an approved injection docket number before disposing of salt water.
8. Notify K.C.C. within 10 days when injection commences or terminates.
9. If an alternate 2 completion, cement in the production pipe from below any usable water to surface within 120 days of spud date.

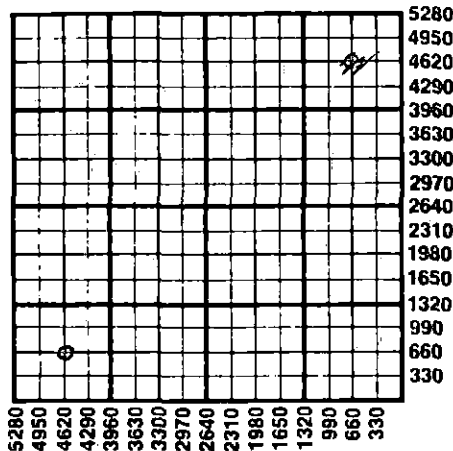

State Corporation Commission of Kansas
Conservation Division
200 Colorado Derby Building
Wichita, Kansas 67202
(316) 263-3238