

CARD MUST BE TYPED

State of Kansas

CARD MUST BE SIGNED

# NOTICE OF INTENTION TO DRILL

(see rules on reverse side)

Starting Date April 22, 1986  
month day year **22**

API Number 15- 009-24,1930000

OPERATOR: License # 4087  
Name Williamson Drilling, Inc.  
Address 5501 Navajo  
City/State/Zip Great Bend, KS 67530  
Contact Person Terry L. Williamson  
Phone 316-793-8229

NE SE SE Sec. 14 Twp. 16 S, Rg. 11 East  West  
..... 990 ..... Ft. from South Line of Section  
..... 990 ..... Ft. from East Line of Section

(Note: Locate well on Section Plat on reverse side)

CONTRACTOR: License # 4087  
Name Williamson Drilling, Inc.  
City/State Great Bend, KS 67530

Nearest lease or unit boundary line ..... 990 ..... feet  
County ..... Barton .....

Well Drilled For:	Well Class:	Type Equipment:
<input checked="" type="checkbox"/> Oil <input type="checkbox"/> SWD	<input type="checkbox"/> Infield	<input checked="" type="checkbox"/> Mud Rotary
<input type="checkbox"/> Gas <input type="checkbox"/> Inj	<input checked="" type="checkbox"/> Pool Ext.	<input type="checkbox"/> Air Rotary
<input type="checkbox"/> OWWO <input type="checkbox"/> Expl	<input type="checkbox"/> Wildcat	<input type="checkbox"/> Cable

Lease Name... Mamie ..... Well #... 1 .....  
Ground surface elevation ..... 1818 ..... feet MSL  
Domestic well within 330 feet: 1880EGL —yes  no   
Municipal well within one mile: —yes  no

If OWWO: old well info as follows:  
Operator .....

Depth to bottom of fresh water..... 100 .....  
Depth to bottom of usable water ..... 350-360 .....  
Surface pipe by Alternate: 1 X 2

I certify that well will comply with K.S.A. 55-101, et seq., plus eventually plugging hole to KCC specifications.  
Date 4-21-86 ..... Signature of Operator or Agent Terry L. Williamson Title President .....

Surface pipe planned to be set ..... 420 .....  
Conductor pipe required ..... No .....  
Projected Total Depth ..... 3300 ..... feet  
Formation Arbuckle .....

For KCC Use:  
Conductor Pipe Required ..... feet; Minimum Surface Pipe Required ..... 360 ..... feet per Alt. 1  
This Authorization Expires 10-22-86 ..... Approved By 4-22-86 .....


*[Signature]*  
feet 360

Must be filed with the K.C.C. five (5) days prior to commencing well  
This card void if drilling not started within six (6) months of date received by K.C.C.

**Important procedures to follow:**

1. Notify District office before setting surface casing.
2. Set surface casing by circulating cement to the top.
3. File completion forms ACO-1 with K.C.C. within 90 days of well completion, following instructions on ACO-1, side 1, and including copies of wireline logs.
4. Notify District office 48 hours prior to old well workover or re-entry.
5. Prior to filing Intent, prepare a proposed plugging plan in case well is D & A, then obtain approval of plan when calling district office prior to setting surface pipe.
6. Submit plugging report (CP-4) to K.C.C. after plugging is completed.
7. Obtain an approved injection docket number before disposing of salt water.
8. Notify K.C.C. within 10 days when injection commences or terminates.
9. If an alternate 2 completion, cement in the production pipe from any usable water to surface within 120 days of spud date.

**A Regular Section of Land  
1 Mile = 5,280 Ft.**

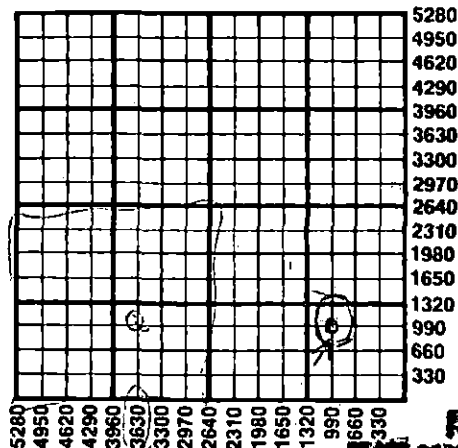

**RECEIVED**  
**STATE CORPORATION COMMISSION**

**APR 22 1986**  
**04-22-86**  
**CONSERVATION DIVISION**  
**Wichita, Kansas**

State Corporation Commission of Kansas  
Conservation Division  
200 Colorado Derby Building  
Wichita, Kansas 67202  
(316) 263-3238