

CARD MUST BE TYPED

NOTICE OF INTENTION TO DRILL

(see rules on reverse side)

CARD MUST BE SIGNED

Starting Date: 1 9 85
 month day year 2:45

OPERATOR: License # 5504
 Name DERRICK-AMERICAN OIL, INC.
 Address 225 North Market - Suite 330
 City/State/Zip Wichita, Kansas 67202
 Contact Person Jim Thompson
 Phone 316/262-0506

CONTRACTOR: License # 5929
 Name DUKE DRILLING CO., INC.
 City/State Great Bend, Kansas 67530

Well Drilled For: Well Class: Type Equipment:

☒ Oil ☒ Swd ☒ Infield ☒ Mud Rotary
☐ Gas ☐ Inj ☐ Pool Ext. ☐ Air Rotary
☒ OWWO ☐ Expl ☐ Wildcat ☐ Cable

If OWWO: old well info as follows:

Operator Globe Oil & Refinery Company
 Well Name Otilia Woydziak #1
 Comp Date 3/31/46 Old Total Depth 3350

Projected Total Depth 3350 feet

Projected Formation at TD Arbuckle

Expected Producing Formations Arbuckle

I certify that we will comply with K.S.A. 55-101, et seq., plus eventually plugging hole to K.C.C. specifications.

Date 1/8/85 Signature of Operator or Agent Sally R. Byers Title

API Number 15- 009-19236-0001

C-N/2 SW NW Sec. 7 Twp. 16 S, Rge. 11. ☐ East
 (location) ☒ West

3630 Ft North from Southeast Corner of Section
 4620 Ft West from Southeast Corner of Section
 (Note: Locate well on Section Plat on reverse side)

Nearest lease or unit boundary line 330 feet.

County Barton

Lease Name Woydziak "B" Well# 1

Domestic well within 330 feet: ☐ yes ☒ no

Municipal well within one mile: ☐ yes ☒ no

Depth to Bottom of fresh water 215 feet

Lowest usable water formation Dakota

Depth to Bottom of usable water 310 feet


Surface pipe by Alternate: 1 ☐ 2 ☒

Surface pipe to be set 237 feet

Conductor pipe if any required feet

Ground surface elevation 1833 feet MSL

This Authorization Expires 7-8-85

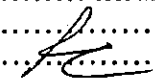Approved By 1-8-85 

Date 1/8/85 Signature of Operator or Agent Sally R. Byers Title Agent Form C-1 4/84


2MHC/KOHE 1-8-85

RECEIVED
STATE CORPORATION COMMISSION

Must be filed with the K.C.C. five (5) days prior to commencing well
This card void if drilling not started within six (6) months of date received by K.C.C.

JAN 8 1985
1-8-85
CONSERVATION DIVISION
Wichita, Kansas

A Regular Section of Land
1 Mile = 5,280 Ft.

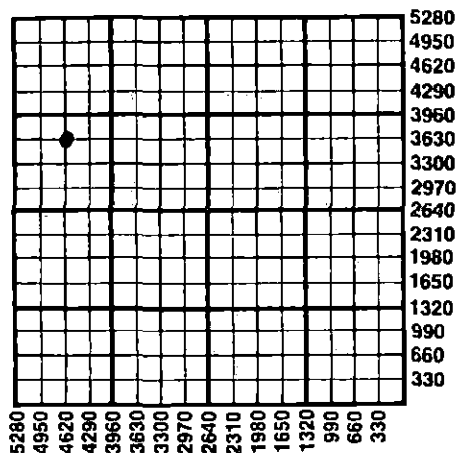

Important procedures to follow :

1. Notify District office before setting surface casing.
2. Set surface casing by circulating cement to the top.
3. File completion forms ACO-1 with K.C.C. within 90 days of well completion, following instructions on ACO-1, side 1, and including copies of wireline logs.
4. Notify District office 48 hours prior to old well workover or re-entry.
5. Prior to plugging, prepare a plugging plan, then obtain agreement from the appropriate district office for an approved plugging plan.
6. *Submit plugging report (CP-4) to K.C.C. after plugging is completed.*
7. Obtain an approved injection docket number before disposing of salt water.
8. Notify K.C.C. within 10 days when injection commences or terminates.
9. If an alternate 2 completion, cement in the production pipe from below any usable water to surface within 120 days of spud date.

State Corporation Commission of Kansas
Conservation Division
200 Colorado Derby Building
Wichita, Kansas 67202
(316) 263-3238