


WELL PLUGGING RECORD

Give All Information Completely
Make Required Affidavit
File or Deliver Report to
Conservation Division
State Corporation Comm.
245 North Water
Wichita, KS 67202

Hodgeman County, Sec. 36 Twp. 24S Rge. 23W E/M
Location as "NE/CNW $\frac{1}{2}$ SW $\frac{1}{2}$ " or footage from lines
NW SE
Lease Owner PICRELL DRILLING COMPANY
Lease Name HUBIN "F" Well No. 1
Office Address 205 LITWIN BLDG., WICHITA, KS. 67202
Character of Well (Completed as Oil, Gas or Dry Hole)

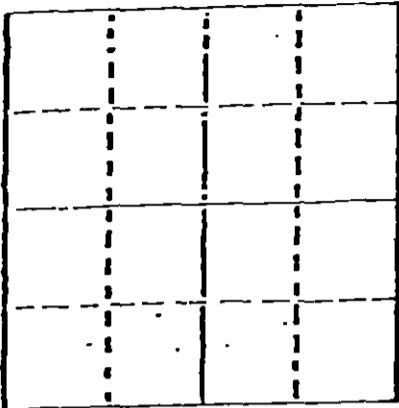

Location of well correctly on above Section Plat

Dry Hole
Date Well completed 10-09-78 19
Application for plugging filed 10-09-78 19
Application for plugging approved 10-09-78 19
Plugging commenced 10-09-78 19
Plugging completed 10-09-78 19
Reason for abandonment of well or producing formation
Dry Hole

If a producing well is abandoned, date of last production 19

Was permission obtained from the Conservation Division or its agents before plugging was commenced? Yes

Name of Conservation Agent who supervised plugging of this well William T. Owens
Producing formation Depth to top Bottom Total Depth of Well 4825
Show depth and thickness of all water, oil and gas formations.

OIL, GAS OR WATER RECORDS CASING RECORD

| FORMATION | CONTENT | FROM | TO | SIZE | PUT IN | PULLED OUT |
|-----------|---------|------|----|-------|--------|------------|
| | | | | 8 5/8 | 354 | None |
| | | | | | | |
| | | | | | | |

Describe in detail the manner in which the well was plugged, indicating where the mud plug was placed and the method or methods used in introducing it into the hold. If cement or other plugs were used, state the character of same and depth placed, from feet to feet for each plug set.
50 sacks at 360'
12 sacks at 40'
3 sacks in rathole Comp. 3:30PM 10-9-78

RECEIVED
STATE CORPORATION COMMISSION

NOV - 1 1978

CONSERVATION DIVISION
Wichita, Kansas 11-1-78

(If additional description is necessary, use BACK of this sheet)

Name of Plugging Contractor PICKRELL DRILLING COMPANY

STATE OF Kansas COUNTY OF Sedgwick, ss.
C. W. Sebitts (employee of owner) or (owner or operator)

I, the above-described well, being first duly sworn on oath, says: That I have knowledge of the facts, statements, and matters herein contained and the log of the above-described well as filed and that the same are true and correct. So help me God. By: C. W. Sebitts

(Signature) *[Signature]*
205 LITWIN BLDG., WICHITA, KS. 67202
(Address)

SUBSCRIBED AND SWORN TO before me this 25 day of October, 1978

My commission expires

[Signature]
Jo Ann Sarver
Notary Public.



ROTARY DRILLING LOG

COMPANY: PICKRELL DRILLING COMPANY
205 LITWIN BLDG.
WICHITA, KS. 67202
LOCATION: HUBIN "F" #1
NW SE Sec. 36-24S-23W
HODGEMAN COUNTY, KANSAS
CONTRACTOR: **PICKRELL DRILLING COMPANY**
Wichita, Kansas

Rotary Drilling Commenced 09-30-78
Rotary Drilling Completed 10-09-78

CASING RECORD: Surf. casing 8 5/8" set at 354' with 200sx. Comp. 9-30-78 @ 6:45PM

LOG

(Figures indicate bottom of formation — measurements from top of rotary bushing.)

| | |
|--------------------|------|
| Topsoil-Clay-Rock | 40 |
| Shale | 130 |
| Shale | 229 |
| Sand | 258 |
| Shale | 290 |
| Shale | 300 |
| Shale | 620 |
| Sand | 705 |
| Shale | 780 |
| Shale | 1040 |
| Sand | 1170 |
| Shale & Sd. Strgs. | 1555 |
| Shale | 1560 |
| Shale | 1601 |
| Shale | 1786 |
| Shale | 2260 |
| Shale & Lime | 2480 |
| Lime & Shale | 2655 |
| Lime | 2780 |
| Lime & Shale | 2900 |
| Lime & Shale | 3040 |
| Lime & Shale | 3190 |
| Lime & Shale | 3310 |
| Lime & Shale | 3442 |
| Lime & Shale | 3555 |
| Lime & Shale | 3680 |
| Lime & Shale | 3861 |
| Lime & Shale | 4045 |
| Lime & Shale | 4150 |
| Lime & Shale | 4263 |
| Lime | 4375 |
| Lime & Shale | 4475 |
| Lime & Shale | 4553 |
| Lime | 4625 |
| Lime & Shale | 4690 |
| Lime | 4753 |
| Lime | 4815 |
| Lime | 4825 |

RECEIVED
STATE CORPORATION COMMISSION
NOV - 1 1978
CONSERVATION DIVISION
Wichita, Kansas

The undersigned, C. W. Sebitts, Attorney-in-Fact for PICKRELL DRILLING COMPANY, hereby certifies in behalf of said Company, that the above is a true and correct log of the formation encountered in drilling the above well as reflected by the Daily Drilling Reports.

PICKRELL DRILLING COMPANY
By [Signature]
Attorney-in-Fact
~~Jo Ann Sarver~~

STATE OF KANSAS }
COUNTY OF SEDGWICK } ss.:

On this 25 day of October, 1978, before me the undersigned, a Notary Public, in and for the County and State aforesaid, personally appeared C. W. Sebitts, to me known to be the identical person who subscribed the name of PICKRELL DRILLING COMPANY to the foregoing instrument as its Attorney-in-Fact and acknowledged to me that he executed the same as his free and voluntary act and deed, and as the free and voluntary act and deed of such company, for the uses and purposes therein set forth.

Given under my hand and seal of office the day and year last above written.

My commission expires: _____

[Signature]
Notary Public
Jo Ann Sarver

