

STATE OF KANSAS
STATE CORPORATION COMMISSION

WELL PLUGGING RECORD

Give All Information Completely
Make Required Affidavit
Mail or Deliver Report to:
Conservation Division
State Corporation Commission
211 No. Broadway
Wichita, Kansas

Hodgeman County, Sec. 2 Twp. 24S Rge. 24 (E) (W)

Location as "NE/CNW/SW" or footage from lines NE SW

Lease Owner Thunderbird Drilling, Inc.

Lease Name Schrader "D" Well No. 1

Office Address P. O. Box 18407- Wichita, Kansas 67218

Character of Well (completed as Oil, Gas or Dry Hole) Dry Hole

Date well completed 6/4/76 19

Application for plugging filed 6/4/76 19

Application for plugging approved 6/4/76 19


Plugging commenced 6/4/76 19

Plugging completed 6/4/76 19

Reason for abandonment of well or producing formation

If a producing well is abandoned, date of last production 19

Was permission obtained from the Conservation Division or its agents before plugging was commenced? Yes

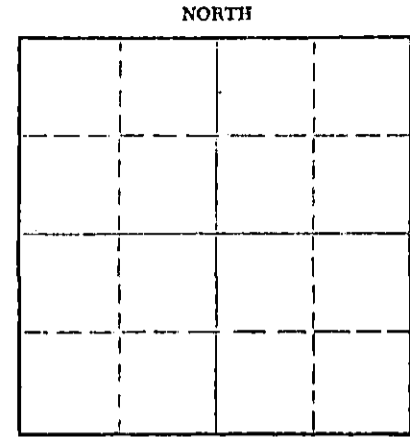

Locate well correctly on above Section Plat

Name of Conservation Agent who supervised plugging of this well Leo Massey

Producing formation Depth to top Bottom Total Depth of Well 4838 Feet

Show depth and thickness of all water, oil and gas formations.

OIL, GAS OR WATER RECORDS

CASING RECORD

FORMATION	CONTENT	FROM	TO	SIZE	PUT IN	PULLED OUT
Surface		0	514'	8 5/8"	514'	0

Describe in detail the manner in which the well was plugged, indicating where the mud fluid was placed and the method or methods used in introducing it into the hole. If cement or other plugs were used, state the character of same and depth placed, from feet to feet for each plug set.

1st Plug 500' w/50 sx
2nd Plug 40' w/15 sx

RECEIVED
STATE CORPORATION COMMISSION

JUN 10 1976

6-18-76

CONSERVATION DIVISION
WICHITA, KANSAS

(If additional description is necessary, use BACK of this sheet)

Name of Plugging Contractor Thunderbird Drilling, Inc.

Address P. O. Box 18407- Wichita, Kansas 67218

STATE OF KANSAS, COUNTY OF SEDGWICK, ss.
Burke Krueger

(employee of owner) or (owner or operator) of the above-described well, being first duly sworn on oath, says: That I have knowledge of the facts, statements, and matters herein contained and the log of the above-described well as filed and that the same are true and correct. So help me God.

(Signature)

Burke Krueger

P. O. Box 18407- Wichita, Kansas

(Address)

Subscribed and Sworn to before me this 10th day of June, 1976

Gloria DeJesus

Gloria DeJesus

Notary Public.

My commission expires 3-25-80



DRILLERS LOG

Company Thunderbird Drilling, Inc. Contractor Thunderbird Drilling, Inc.

Elevation 2476 K.B.

Farm Schrader "D"

Well No. #1

Casing 8 5/8" 514' w/300 sx

Location NE SW
Section 2-24S-24W

Production

County Hodgeman

<u>From</u>	<u>To</u>	<u>Description</u>
0	30	Sod
30	55	Post Rock
55	245	Shale & Sand
245	274	Shale & Shells
274	514	Shale & Sand Streaks
514	1110	Shale & Red Bed
1110	1295	Sand
1295	1390	Shale
1390	1611	Shale & Red Bed
1611	1635	Anhydrite
1635	1800	Shale & Shells
1800	1885	Shale & Lime Streaks
1885	2250	Shale & Shells
2250	3745	Shale & Lime
3745	4295	Lime & Shale
4295	4410	Shale & Lime
4410	4635	Lime & Shale
4635	4750	Lime
4750	4795	Lime & Shale
4795	TD	Lime

RECEIVED
STATE COMMISSION COMMISSION

JUN 18 1976

STATE OF KANSAS)
) ss.
COUNTY OF SEDGWICK)

CONSERVATION DIVISION
Wichita, Kansas

I, Burke Krueger, of Thunderbird Drilling, Inc. upon oath states that the above and foregoing is a true and correct copy from the Daily Drilling Report from your Schrader "D" #1

Burke Krueger

Subscribed and sworn to before me this 10th day of June, 19 76

Gloria DeJesus
Gloria DeJesus Notary Public

My commission expires: 3-25-80

