


WELL PLUGGING RECORD

Give All Information Completely
Make Required Affidavit
Mail or Deliver Report to:
Conservation Division
State Corporation Commission
800 Bitting Building
Wichita, Kansas

Hodgeman County. Sec. 2 Twp. 24 Rge. (E) 24 (W)
Location as "NE/CNW $\frac{1}{4}$ SW $\frac{1}{4}$ " or footage from lines SW $\frac{1}{4}$, NW $\frac{1}{4}$, NW $\frac{1}{4}$
Lease Owner Harbar Drilling Co. Etal
Lease Name Schraeder Well No. I
Office Address 1019 Central Bldg., Wichita, Kansas
Character of Well (completed as Oil, Gas or Dry Hole) Rotary Dry Hole
Date well completed 5/25/51 19
Application for plugging filed 5/25/51 Verbal 19
Application for plugging approved 5/25/51 Verbal 19
Plugging commenced 5/25/51 19
Plugging completed 5/26/51 19
Reason for abandonment of well or producing formation Dry Hole
If a producing well is abandoned, date of last production X 19
Was permission obtained from the Conservation Division or its agents before plugging was commenced? Yes

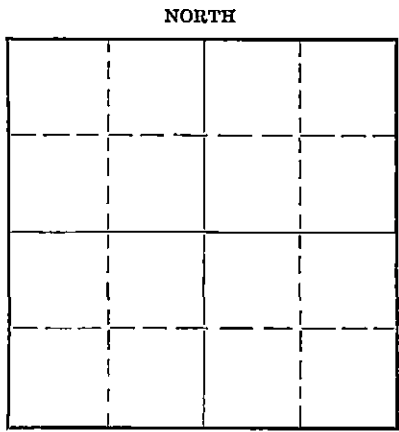

Locate well correctly on above Section Plat

Name of Conservation Agent who supervised plugging of this well Merle Rives
Producing formation None Depth to top X Bottom X Total Depth of Well 5038 Feet
Show depth and thickness of all water, oil and gas formations.

OIL, GAS OR WATER RECORDS

CASING RECORD

Formation	Content	From	To	Size	Put In	Pulled Out
Surface sand & Soil	Dry	0	240'	10 3/4	235	None

Describe in detail the manner in which the well was plugged, indicating where the mud fluid was placed and the method or methods used in introducing it into the hole. If cement or other plugs were used, state the character of same and depth placed, from _____ feet to _____ feet for each plug set.

Hole was filled with rotary mud from T. D. (5038) back to 235', where a Halliburton plug was set and 20 sacks cement was dumped on top plug. Casing was then filled with rotary mud back to 35' where another Halliburton plug was set and 100# of cotton seed hulls was dumped on top plug and 10 sacks cement was dumped on top of hulls filling surface casing to top and overflowing into bottom of cellar.

Surface casing was circulated with cement at time it was set.

MAY 31 1951 5-31-51
CONSERVATION DIVISION
Wichita, Kansas

(If additional description is necessary, use BACK of this sheet)

Correspondence regarding this well should be addressed to Harbar Drilling Company
Address Harbar Drilling Co. 1019 Central Bldg., Wichita, Kansas

STATE OF Kansas, COUNTY OF Barton, ss.
I, Roy Cook (employee of owner) or (owner or operator) of the above-described well, being first duly sworn on oath, says: That I have knowledge of the facts, statements, and matters herein contained and the log of the above-described well as filed and that the same are true and correct. So help me God.

(Signature) Roy Cook

SUBSCRIBED AND SWORN TO before me this 28th day of May 1951

(Address) Roy Gillig
Notary Public.

My commission expires 9-4-54

23-3278-5 4-50-10M
PLUGGING
FILE SEC 2-24-51
BOOK PAGE 84 LINE 37