


STATE OF KANSAS
STATE CORPORATION COMMISSION

WELL PLUGGING RECORD

Give All Information Completely
Make Required Affidavit
Mail or Deliver Report to:
Conservation Division
State Corporation Commission
212 North Market, Insurance Bldg.
Wichita, Kansas

Hodgeman County. Sec. 9 Twp. 24S Rge. 24 (E) (W)
Location as "NE/CNW%SW%" or footage from lines C W/2 NW NE
Lease Owner Dunne-Gardner Drilling Co., Inc.
Lease Name Benish Well No. 1
Office Address 300 Schweiter Building, Wichita 2, Kansas
Character of Well (completed as Oil, Gas or Dry Hole) dry hole
Date well completed June 12, 19 63
Application for plugging filed June 12, 19 63
Application for plugging approved June 12, 19 63
Plugging commenced June 12, 19 63
Plugging completed June 12, 19 63
Reason for abandonment of well or producing formation dry hole

NORTH

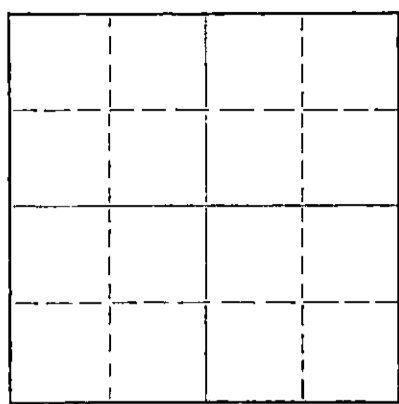

Locate well correctly on above
Section Plat

If a producing well is abandoned, date of last production 19
Was permission obtained from the Conservation Division or its agents before plugging was commenced? yes

Name of Conservation Agent who supervised plugging of this well Hugh Scott
Producing formation _____ Depth to top _____ Bottom _____ Total Depth of Well 4800 Feet
Show depth and thickness of all water, oil and gas formations.

OIL, GAS OR WATER RECORDS

CASING RECORD

FORMATION	CONTENT	FROM	TO	SIZE	PUT IN	PULLED OUT
Surface Pipe		0	238'	8-5/8"	5-30-63	none

Describe in detail the manner in which the well was plugged, indicating where the mud fluid was placed and the method or methods used in introducing it into the hole. If cement or other plugs were used, state the character of same and depth placed, from _____ feet to _____ feet for each plug set.

Mud to 500'. Plug - 1/4 sack Hulls, 20 sacks cement.
Mud to 240'. Plug - 1/4 sack Hulls, 25 sacks Cement.
Mud to 40'. Plug - 1/2 sack Hulls, 10 sacks Cement.

RECEIVED
STATE CORPORATION COMMISSION

JUN 13 1963

CONSERVATION DIVISION
WICHITA, KANSAS

(If additional description is necessary, use BACK of this sheet)

Name of Plugging Contractor _____
Address _____

STATE OF KANSAS COUNTY OF SEDGWICK, ss.
Don Gardner (employee of owner) or (~~owner~~) of the above-described well, being first duly sworn on oath, says: That I have knowledge of the facts, statements, and matters herein contained and the log of the above-described well as filed and that the same are true and correct. So help me God.

(Signature) Don Gardner
300 Schweiter Building, Wichita 2, Kansas
(Address)

SUBSCRIBED AND SWORN TO before me this 12th day of June, 19 63

My commission expires November 9, 1965

Marilyn E. Fox
Marilyn E. Fox Notary Public.

INVOICED
DATE 6/13/63
INV. NO. 7258-4

16

15-083-10054-0000

DRILLER'S LOG

OPERATOR: Dunne-Gardner Drilling Co., Inc.
 300 Schweiter Building, Wichita 2, Kansas

LEASE: Benish

WELL: No. 1

LOCATION: C W/2 NW NE Section 9-24S-24W
 Hodgeman County, Kansas

DATE COMMENCED: May 29, 1963

DATE COMPLETED: June 12, 1963

CONTRACTOR: Dunne-Gardner Drilling Co., Inc.

TOTAL DEPTH: 4800'

CASING: Set 8-5/8" Surface Pipe at 238' with 200 sacks cement

<u>FROM</u>	<u>TO</u>	
0	242	Rock and Blue Shale
242	1100	Shale and Sand
1100	1310	Sand
1310	1624	Red Bed and Shale
1624	1647	Anhydrite
1647	1950	Shale and Shells
1950	2210	Shale - Lime Streaks
2210	2677	Lime and Shale
2677	2860	Lime
2860	3942	Lime and Shale
3942	4003	Lime
4003	4151	Lime and Shale
4151	4740	Lime
4740	4765	Chert and Lime
4765	4800	Lime and Dolomite
4800		Total Depth

RECEIVED
 STATE CORPORATION COMMISSION
 JUN 25 1963
 CONSERVATION DIVISION
 Wichita, Kansas


I certify the above to be true and correct to the best of my knowledge and belief.

DUNNE-GARDNER DRILLING CO., INC.

By 
 Don Gardner

Subscribed and sworn to before me this 14th day of June, 1963.

My Commission Expires:
November 9, 1965

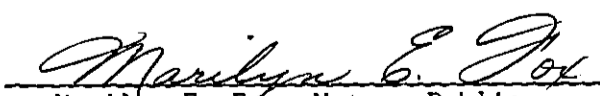
 Marilyn E. Fox, Notary Public