

STATE OF KANSAS
STATE CORPORATION COMMISSION

WELL PLUGGING RECORD

Give All Information Completely
Make Required Affidavit
Mail or Deliver Report to:
Conservation Division
State Corporation Commission
800 Bittling Building
Wichita, Kansas

Hodgeman County. Sec. 10 Twp. 24 Rge. 24 (NW) (W)

Location as "NE/CNW/SW" or footage from lines NE SW SW 1/4

Lease Owner M. B. Armer

Lease Name Rogers Well No. 1

Office Address 710 Petroleum Bldg., Wichita, Kansas

Character of Well (completed as Oil, Gas or Dry Hole) dry

Date well completed Sept. 21 19 52

Application for plugging filed " 19 52

Application for plugging approved " 19 52


Plugging commenced " 19 52

Plugging completed " 19 52

Reason for abandonment of well or producing formation dry

If a producing well is abandoned, date of last production _____ 19 _____

Was permission obtained from the Conservation Division or its agents before plugging was commenced? yes

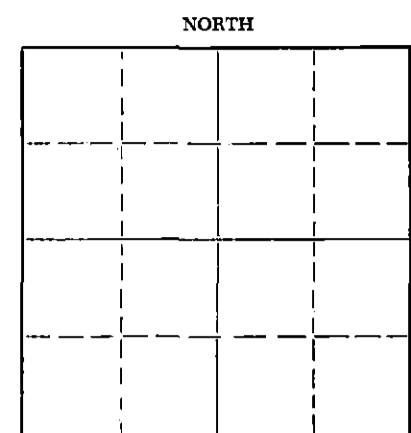

Locate well correctly on above Section Plat

Name of Conservation Agent who supervised plugging of this well C. S. Stough

Producing formation _____ Depth to top _____ Bottom _____ Total Depth of Well 4834 Feet

Show depth and thickness of all water, oil and gas formations.

OIL, GAS OR WATER RECORDS

CASING RECORD

FORMATION	CONTENT	FROM	TO	SIZE	PUT IN	PULLED OUT
				8 5/8	203	none

Describe in detail the manner in which the well was plugged, indicating where the mud fluid was placed and the method or methods used in introducing it into the hole. If cement or other plugs were used, state the character of same and depth placed, from _____ feet to _____ feet for each plug set.

Filled hole full of heavy Mud and set plug and 20 sacks cement at 200 ft. through drill pipe. Mudded hole to 35 ft., set plug and 10 sacks cement at the surface.

RECEIVED
STATE CORPORATION COMMISSION
10-1-52
CONSERVATION DIVISION
Wichita, Kansas

Name of Plugging Contractor M. B. Armer
Address Wichita, Kansas.

STATE OF Kansas, COUNTY OF Sedgwick, ss.
L. C. Sponenberg (employee of owner) of the above-described well, being first duly sworn on oath, says: That I have knowledge of the facts, statements, and matters herein contained and the log of the above-described well as filed and that the same are true and correct. So help me God.

(Signature) L. C. Sponenberg
(Address) _____

SUBSCRIBED AND SWORN TO before me this 30 day of Sept., 19 52

My commission expires 9/17/55
Walter D. ... Notary Public.

PLUGGING
FILE SEC 10 T 24 R 24
BOOK PAGE 46 LINE 12

LOG

Company: Armer-Koplin
 Contractor: M. B. Armer (Unit Rig)
 Drilling Commenced: 9/5/52
 Drilling Completed: 9/21/52
 Elevation: 2497 D.F.
 2500 R.B.

Farm: Rogers #1
 Location: Approx. NE SW SW Sec. 10-24S-24W
 Hodgeman County, Kansas
 Casing record: 8-5/8" casing at 203'
 with 150 sacks cement

(figures below indicate bottoms)

Surface Clay & Shells	100
Blue Shale	203
Sand	300
Shale & Sand-Streaks	700
Sand	850
Red Bed & Shale & Shells	1130
Sand	1315
Shale, Shells & Red Bed	1630
Anhydrite	1665
Shale & Shells	1960
Shale & Lime	4806
Lime	4834
R.T.D.	4834

FORMATION TOPS (R.B. Meas.)

Heebner	4017
Lansing-Kansas City	4102
Mississippi Chert	4760
White Lime	4781
Dolomite	4812

I hereby certify that this is a true and correct log of the above described well as shown by the drilling reports.

M. B. ARMER

By *C. J. Sprouber*

STATE OF KANSAS
 COUNTY OF SEDGWICK

Subscribed and sworn to before me, a notary public, in and for said County and State this 29th day of September, 1952.

STATE CORPORATION COMMISSION

OCT - 1 1952

CONSERVATION DIVISION
 Wichita, Kansas

My Commission expires: Sept. 17, 1955.

Joseph Swanton
 Notary Public

PLUGGING
 FILE SEC 10 T24 S24
 BOOK PAGE 46 LINE 42