


STATE OF KANSAS  
STATE CORPORATION COMMISSION

WELL PLUGGING RECORD

Give All Information Completely  
Make Required Affidavit  
Mail or Deliver Report to  
Conservation Division  
State Corporation Comm.  
245 North Water  
Wichita, KS 67202

Gray County. Sec. 23 Twp. 24S Rge. 30 x W  
Location as "NE/CNW 1/4 SW 1/4" or footage from lines C SE SW

Lease Owner Pendleton Land & Exploration, Inc.  
Lease Name Katherine Hall "A" Well No. #1  
Office Address 1410 Security Life Bldg., Denver, Colo. 80202  
Character of Well (Completed as Oil, Gas or Dry Hole) Dry Hole

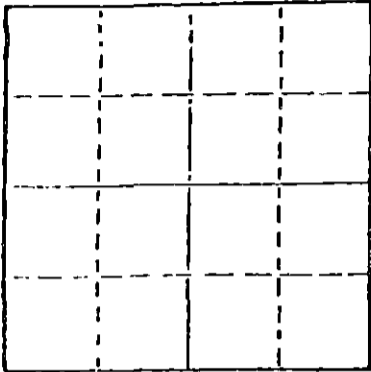

Locate well correctly on above  
Section Plat

Date Well completed 12-12-79 19  
Application for plugging filed 12-12-79 19  
Application for plugging approved 12-12-79 19  
Plugging commenced 12-12-79 19  
Plugging completed 12-12-79 19  
Reason for abandonment of well or producing formation Commercial quantities of oil not found  
If a producing well is abandoned, date of last production 19

Was permission obtained from the Conservation Division or its agents before plugging was commenced? Yes

Name of Conservation Agent who supervised plugging of this well Clarence Thomas, Jr.  
Producing formation \_\_\_\_\_ Depth to top \_\_\_\_\_ Bottom \_\_\_\_\_ Total Depth of Well 5069'  
Show depth and thickness of all water, oil and gas formations.

OIL, GAS OR WATER RECORDS

CASING RECORD

FORMATION	CONTENT	FROM	TO	SIZE	PUT IN	PULLED OUT
				8 5/8"	510'	None

Describe in detail the manner in which the well was plugged, indicating where the mud fluid was placed and the method or methods used in introducing it into the hold. If cement or other plugs were used, state the character of same and depth placed, from \_\_\_\_\_ feet to \_\_\_\_\_ feet for each plug set.

Plug @ 500' w/50 sx.  
Plug @ 40' w/10 sx.  
Rat Hole 5 sx.

RECEIVED  
STATE CORPORATION COMMISSION

JAN 13 1980

CONSERVATION DIVISION  
Wichita, Kansas

1-18-80

(If additional description is necessary, use BACK of this sheet)

Name of Plugging Contractor Rains & Williamson Oil Co., Inc.

STATE OF Kansas COUNTY OF Sedgwick, ss.  
Wilson Rains, President of Rains & Williamson Oil Co., Inc. (employee of owner) or (owner or operator) of the above-described well, being first duly sworn on oath, says: That I have knowledge of the facts, statements, and matters herein contained and the log of the above-described well as filed and that the same are true and correct. So help me God.

(Signature) Wilson Rains  
435 Page Court, 220 W. Douglas, Wichita, Kansas 67202  
(Address)

SUBSCRIBED AND SWORN TO before me this 17 day of December, 19 79

My commission expires 10-4-83

Juanita M. Green  
Notary Public.



DRILLER'S LOG

COMPANY: Pendleton Land & Exploration, Inc. SEC. 23 T. 24S R. 30W

WELL NAME: Katherine Hall "A" #1

LOC. C SE SW

COUNTY: Gray

RIG NO. #2

TOTAL DEPTH 5069'

ELEVATION

COMMENCED: 12-1-79

COMPLETED: 12-12-79

CONTRACTOR: Rains & Williamson Oil Co., Inc.

CASING RECORD:

SURFACE: 8 5/8" @ 510' w/300 sx. Lite, 3% cc. and 150 sx. Class H, 3% cc.

PRODUCTION: D&A

LOG

(Figures Indicate Bottom of Formations)

Sand, Clay & Shale	500
Shale	2264
Shale & Lime	2491
Lime	2642
Lime & Shale	3411
Lime	3803
Lime & Shale	2975
Lime	4143
Lime & Shale	4303
Lime	4598
Lime & Shale	4834
Shale & Lime	5069
<u>ROTARY TOTAL DEPTH</u>	<u>5069</u>

RECEIVED  
STATE CORPORATION COMMISSION

JAN 18 1980

CONSERVATION DIVISION  
Wichita, Kansas

STATE OF Kansas )

COUNTY OF Sedgwick )

SS:

I, Wilson Rains, President of Rains & Williamson Oil Co., Inc.

upon oath state that the above and foregoing is a true and correct copy of the log of the

Katherine Hall "A" #1 well.

*Wilson Rains*

Wilson Rains

Subscribed and sworn to before me this 17 day of December, 1979.

My Appointment Expires:

10-4-83

*Juanita M. Green*  
Juanita M. Green

