


STATE OF KANSAS
STATE CORPORATION COMMISSION

Give All Information Completely
Make Required Affidavit
Mail or Deliver Report to:
Conservation Division
State Corporation Commission
800 Bitting Building
Wichita, Kansas

Comp. cons. 11.11.11

WELL PLUGGING RECORD

NORTH

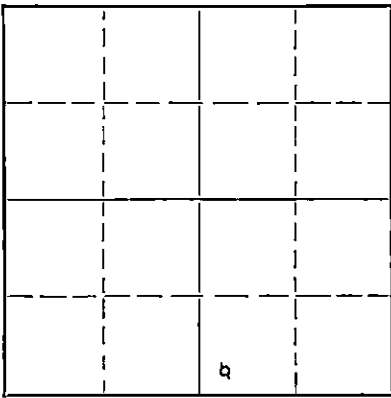

Locate well correctly on above
Section Plat

Hodgeman County. Sec. 4 Twp. 24S Rge. 24W (W)
Location as "NE/CNW $\frac{1}{4}$ SW $\frac{1}{4}$ " or footage from lines SW $\frac{1}{4}$ SW $\frac{1}{4}$ SE $\frac{1}{4}$
Lease Owner M. B. Armer
Lease Name Schneider Well No. 1
Office Address 710 Petroleum Building, Wichita 2, Kansas.
Character of Well (completed as Oil, Gas or Dry Hole) Dry Hole
Date well completed February 10 19 52
Application for plugging filed February 10 19 52
Application for plugging approved February 10 19 52
Plugging commenced February 10 19 52
Plugging completed February 10 19 52
Reason for abandonment of well or producing formation Dry
If a producing well is abandoned, date of last production - 19 -
Was permission obtained from the Conservation Division or its agents before plugging was commenced? Yes

Name of Conservation Agent who supervised plugging of this well C. D. Stumpf
Producing formation _____ Depth to top _____ Bottom _____ Total Depth of Well 4829 Feet
Show depth and thickness of all water, oil and gas formations.

OIL, GAS OR WATER RECORDS

CASING RECORD

Formation	Content	From	To	Size	Put In	Pulled Out
				8-5/8"	195'	None

Describe in detail the manner in which the well was plugged, indicating where the mud fluid was placed and the method or methods used in introducing it into the hole. If cement or other plugs were used, state the character of same and depth placed, from _____ feet to _____ feet for each plug set.

Filled hole with mud. Pushed bottom plug to 190' with 15 sacks of cement on top.
Top plug @ 30' with 10 sacks of cement.

(If additional description is necessary, use BACK of this sheet)

Name of Plugging Contractor MID-AMERICA DRILLERS, INC.
Address 605 Union National Bank Building,
Wichita 2, Kansas.

STATE OF KANSAS, COUNTY OF SEDGWICK, ss.
Wm. F. Pielsticker, ~~employee or owner or operator~~ operator) of the above-described well,

being first duly sworn on oath, says: That I have knowledge of the facts, statements, and matters herein contained and the log of the above-described well as filed and that the same are true and correct. So help me God.

(Signature) Wm F Pielsticker
605 Union National Bank Building, Wichita, Ks.
(Address)

SUBSCRIBED AND SWORN to before me this 13th day of February, 19 52

Agnes M. Quinn
Notary Public.

My commission expires March 24, 1955.

PLUGGING
FILE SEC 4 T 24 R 24W
BOOK 144 LINE 12

2-16-52

LOG

COMPANY: M. B. Armer FARM: Schneider No. 1.
 CONTRACTOR: Mid-America Drillers, Inc. LOCATION: SW/4 SW/4 SE/4 Sec.
 DRILLING COMMENCED: 12/12/51 4-24S-24N, Hodgeman
 DRILLING COMPLETED: 2/10/52 County, Kansas.
 ELEVATION: 2487 D. F. CASING RECORD: 8-5/8" set @ 195 ft.
 2479 Gr. w/175 sacks cement.

(Figures below indicate bottoms)

Shale	215
Blue Shale	615
Sand	785
Shale and shells	1150
Sand	1270
Shale	1595
Anhydrite	1640
Shale and Shells	1690
Anhydrite, Shale and Shells	1765
Shale	2280
Lime	2286
Shale	2460
Lime	4710
Cherty Lime	4734
Chert and Lime	4762
Lime and Shale	4820
Lime	4829
Rotary Total Depth	4829 D & A

I hereby certify that this is a true and correct log of the above described well as shown by the drilling reports.

MID-AMERICA DRILLERS, INC.

By

J. M. F. Fickman

STATE OF KANSAS)
) SS.
 COUNTY OF SEDGWICK)

Subscribed and sworn to before me, a notary public, in and for said County and State, this 13th day of February, 1952.

Agnes M. Quinn
 Notary Public

My commission expires: March 24, 1955.

