


STATE OF KANSAS
STATE CORPORATION COMMISSION
Give All Information Completely
Make Required Affidavit
Mail or Deliver Report to:
Conservation Division
State Corporation Commission
212 No. Market
Wichita, Kansas

WELL PLUGGING RECORD

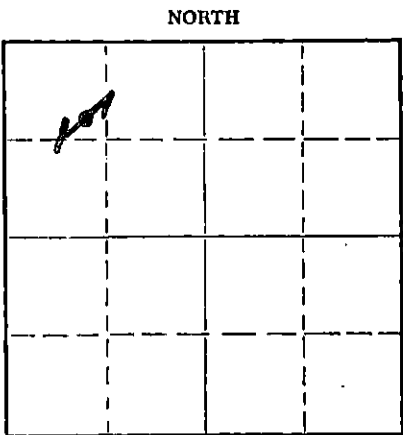

Locate well correctly on above
Section Plat

Hodgeman County, Sec. 3 Twp. 24 Rge. 24 (W)
Location as "NE/CNW&SW&" or footage from lines SE NW NW
Lease Owner Okmar Oil Company
Lease Name Schraeder Well No. 4
Office Address 1130 Wichita Plaza
Character of Well (completed as Oil, Gas or Dry Hole) Water Injection
Date well completed September 15 1951
Application for plugging filed April 10 1968
Application for plugging approved April 11 1968
Plugging commenced April 11 1968
Plugging completed April 12 1968
Reason for abandonment of well or producing formation Casing Failure

If a producing well is abandoned, date of last production 19
Was permission obtained from the Conservation Division or its agents before plugging was commenced? Yes

Name of Conservation Agent who supervised plugging of this well Edgar J. Eves
Producing formation Mississippi Depth to top 4678' Bottom 5028' Total Depth of Well 5230' Feet
Show depth and thickness of all water, oil and gas formations.

OIL, GAS OR WATER RECORDS

CASING RECORD

FORMATION	CONTENT	FROM	TO	SIZE	PUT IN	PULLED OUT
Mississippi	Oil	4677	4713	10"	300	0
				5 1/2	5226	0

Describe in detail the manner in which the well was plugged, indicating where the mud fluid was placed and the method or methods used in introducing it into the hole. If cement or other plugs were used, state the character of same and depth placed, from feet to feet for each plug set.

Mud from T.D. to 1100' set 25 sack plug 1100' to 880', pump 175 sacks plus 6% Gel down casing and let set overnight. Set wood plug at 285' and fill hole with 55 sacks of cement.

RECEIVED
STATE CORPORATION COMMISSION
APR 30 1968
CONSERVATION DIVISION
Wichita, Kansas

(If additional description is necessary, use BACK of this sheet)

Name of Plugging Contractor Allied Cementing
Address P.O. Box 207, Russell, Kansas 67665

STATE OF Kansas, COUNTY OF Sedgwick, ss.
Jim Thatcher (employee of owner) or (owner or operator) of the above-described well, being first duly sworn on oath, says: That I have knowledge of the facts, statements, and matters herein contained and the log of the above-described well as filed and that the same are true and correct. So help me God.

(Signature) JIM THATCHER
1130 Wichita Plaza, Wichita, Kansas.
(Address)

Subscribed and sworn to before me this 29th day of April, 1968

James R. Colvin
Notary Public.



K-083-0023|-0000

Company: Armer-Koplin
 Contractor: Speer Drilling Company
 Drilling commenced: 8/9/51
 Drilling completed: 9/6/51
 Elevation: 2676 Gr. 2478 R.F. 2481 R.B.

Farm: Schrader - well #4
 Location: SE NW NW of Sec. 3-24-24
 Hodgeman County, Kansas
 Casing record: 10" set at 300 ft.
 cemented w/200 sacks
 5 1/2" set at 5226 ft.
 cemented w/300 sacks.

(figures below indicate bottom)

Surface clay	100
Shale & shells	165
Sand	185
Shale & shells	300
Red bed, shale & shells	955
Red bed & shale	1100
Sand	1290
Shale & red bed	1447
Shale & shells	1600
Anhydrite	1635
Shale & shells	2040
Shale, salt & shells	2200
Shale, lime & shells	2330
Shale & lime	2395
Shale & lime shells	2477
Shale & lime	2646
Shale & lime streaks	2735
Shale & lime	4114
Lime	4135
Lime & shale	4194
Lime	4337
Lime & shale	4470
Lime	4589
Lime & shale	4589
Lime	4635
Lime & chert	4666
Lime	4820
Cherty lime	4870
Lime	4886
Cherty lime	4870
Lime	4886
Lime cherty	4993
Lime	5030
Lime & Chert	5172
Lime, sand & chert	5190
Lime & cherty	5230

FORMATION TOPS: (R.B. Meas.)

Anhydrite	1600
Heebner	3948
Toronto	3964
Lans.-Kansas City	4023
Marmaton	4408
Conglomerate	4645
Mississippian	4678
Viola	5045
Simpson	5170
Granite Wash	5225

I hereby certify that this is a true and correct log of the above described well as shown by the drilling reports.

SPEER DRILLING COMPANY

By

J. W. Speer

STATE OF KANSAS)
 COUNTY OF SEDGWICK) SS

Subscribed and sworn to before me, a notary public, in and for said County and State this 11th day of September, 1951.

Hazel Dutton
 Notary Public

My commission expires Sept. 17, 1951.

RECEIVED
 STATE CORPORATION COMMISSION
 APR 11 1968
 CONSERVATION DIVISION
 Wichita, Kansas

Company: Armer-Koplin
 Contractor: Speer Drilling Company
 Drilling commenced: 8/9/51
 Drilling completed: 9/6/51
 Elevation: 2676 Gr. 2478 B.F. 2481 R.B.

15-083-00231-0000
 Farm: Schrader - well #4
 Location: SE NW NW of Sec. 3-24-24
 Hodgeman County, Kansas
 Casing record: 10" set at 300 ft.
 cemented w/200 sacks
 5 1/2" set at 5226 ft.
 cemented w/300 sacks.

(figures below indicate bottom)

Surface clay	100
Shale & shells	165
Sand	185
Shale & shells	300
Red bed, shale & shells	955
Red bed & shale	1100
Sand	1290
Shale & red bed	1447
Shale & shells	1600
Anhydrite	1635
Shale & shells	2040
Shale, salt & shells	2200
Shale, lime & shells	2330
Shale & lms	2395
Shale & lime shells	2477
Shale & lime	2646
Shale & lime streaks	2735
Shale & lime	4114
Lime	4135
Lime & shale	4194
Lime	4337
Lime & shale	4470
Lime	4589
Lime & shale	4589
Lime	4635
Lime & chert	4666
Lime	4820
Cherty lime	4870
Lime	4886
Cherty lime	4870
Lime	4886
Lime cherty	4993
Lime	5030
Lime & Chert	5172
Lime sand & chert	5190
Lime & cherty	5230

FORMATION TOPS: (R.B. Meas.)

Anhydrite	1600
Heebner	3948
Toronto	3964
Lans.-Kansas City	4023
Marmaton	4408
Conglomerate	4645
Mississippian	4678
Viola	5045
Simpson	5170
Granite Wash	5225

I hereby certify that this is a true and correct log of the above described well as shown by the drilling reports.

SPEER DRILLING COMPANY

By

J. W. Speer

STATE OF KANSAS }
 COUNTY OF SEDGWICK } SS

Subscribed and sworn to before me, a notary public, in and for said County and State this 11th day of September, 1951.

Hazel Walker
 Notary Public

My commission expires Sept. 17, 1951.

RECEIVED
 STATE CORPORATION COMMISSION
 APR 30 1968
 CONSERVATION DIVISION
 Wichita, Kansas