

Give All Information Completely  
Make Required Affidavit  
Mail or Deliver Report to:  
Conservation Division  
State Corporation Commission  
211 No. Broadway  
Wichita, Kansas

WELL PLUGGING RECORD

Barton

County. Sec. 4 Twp. 16S Rge. (E) 11 (W)

Location as "NE/CNW&SW" or footage from lines C N/2 N/2 NW

Lease Owner Robinowitz Oil Company

Lease Name FOSTER Well No. 1

Office Address 311 Shell Bldg., Tulsa, Oklahoma

Character of Well (completed as Oil, Gas or Dry Hole) Dry Hole

Date well completed 4-6 19 63

Application for plugging filed 4-6 19 63

Application for plugging approved 4-6 19 63

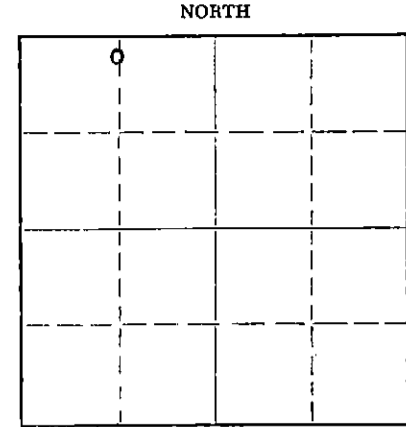
Plugging commenced 4-6 19 63

Plugging completed 4-6 19 63

Reason for abandonment of well or producing formation Dry Hole

If a producing well is abandoned, date of last production \_\_\_\_\_ 19 \_\_\_\_\_

Was permission obtained from the Conservation Division or its agents before plugging was commenced? yes



Locate well correctly on above Section Plat

Name of Conservation Agent who supervised plugging of this well Donald Truan

Producing formation Dry Hole Depth to top \_\_\_\_\_ Bottom \_\_\_\_\_ Total Depth of Well 3249 Feet

Show depth and thickness of all water, oil and gas formations.

OIL, GAS OR WATER RECORDS

CASING RECORD

FORMATION	CONTENT	FROM	TO	SIZE	PUT IN	PULLED OUT
Lansing	gas & water	2887	3136	8-5/8"	252'	none

Describe in detail the manner in which the well was plugged, indicating where the mud fluid was placed and the method or methods used in introducing it into the hole. If cement or other plugs were used, state the character of same and depth placed, from \_\_\_\_\_ feet to \_\_\_\_\_ feet for each plug set.

Mud to 240', 1/4 sk hulls & plug & 25 sks cement thru drill pipe. Mud to 40', 1/2 sk hulls & plug. Cement to bottom of collar. Remainder of cement in rat hole.

RECEIVED  
STATE CORPORATION COMMISSION

APR 16 1963

4-16-63

CONSERVATION DIVISION  
Wichita, Kansas

Name of Plugging Contractor Rotary well drilled - no pipe set.  
Address \_\_\_\_\_

STATE OF OKLAHOMA, COUNTY OF TULSA, ss.  
Joseph Teichman (employee of owner) or (owner or operator) of the above-described well, being first duly sworn on oath, says: That I have knowledge of the facts, statements, and matters herein-contained and the log of the above-described well as filed and that the same are true and correct. So help me God.

(Signature) [Signature]  
P. O. Box 7027, Tulsa, Oklahoma  
(Address)

SUBSCRIBED AND SWORN TO before me this 12th day of April, 19 63

My commission expires 3-17-64

[Signature]  
Notary Public.



SHOLOM DRILLING COMPANY, INC.  
P.O. BOX 7027  
TULSA, OKLAHOMA

COMPANY: Robinowitz Oil Company  
FARM: FOSTER #1  
LOCATION: C N/2 N/2 NW/4 Sec. 4 T16S R11W - Barton County, Kansas  
ROTARY DRILLING CONTRACTOR: Sholom Drilling Company, Inc.

COMMENCED: 3-29-63  
COMPLETED: 4-6-63  
I. P.: D & A

Elevation: 1769' K.B.  
Rotary TD: 3249'

Casing Record:  
8-5/8" @ 252' w/160 sax

L O G

0 - 60 Clay, Rock & Shale  
60 - 252 Shale  
252 - 320 Shale & Shells  
320 - 415 Dry Dakota & Pyrite  
415 - 620 Red Bed  
620 - 650 Anhydrite  
650 - 1135 Shale & Shells  
1135 - 1400 Shale & Sand  
1400 - 1465 Sand & Lime  
1465 - 1775 Lime & Shale  
1775 - 1870 Lime  
1870 - 1910 Lime & Shale  
1910 - 2090 Shale & Shells  
2090 - 2380 Shale & Lime  
2380 - 2535 Sandy Shale w/Lime Strks.  
2535 - 2660 Shale & Lime  
2660 - 2755 Lime & Shale  
2755 - 2781 Lime  
2781 - 2835 Lime & Shale  
2835 - 2890 Shale & Lime  
2890 - 3116 Lime  
3116 - 3204 Lime & Shale & Cong.  
3204 - 3240 Conglomerate  
3240 - 3249 Lime

DST #1 2735-81  
Rec. 150' watery mud

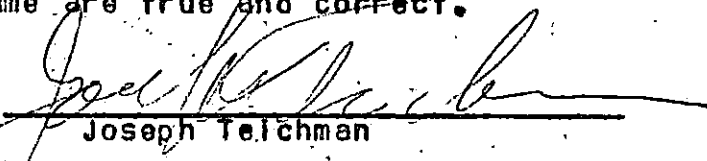
DST #2 2805-2950  
Rec. 1050' VH6CM, 120'  
VSO6M

DST #3 2960-3000  
Rec. 330' watery mud

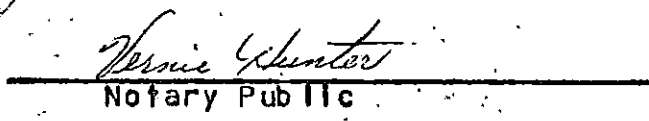
Anhydrite	620'
Topeka	2552'
Heebner	2798'
Toronto	2813'
Douglas	2828'
Lansing	2897'
Base K.C.	3136'
Conglomerate	3214'
Rotary T.D.	3249'

STATE OF OKLAHOMA )  
) ss.  
COUNTY OF TULSA )

I, Joseph Teichman, President of Sholom Drilling Company, Inc. a corporation of the State of Oklahoma, domesticated in the State of Kansas, being first duly sworn under oath, says: That I have knowledge of the facts, statements, and matters herein contained of the above described well as filed and that the same are true and correct.

  
Joseph Teichman

Subscribed and sworn to before me this 12th day of April, 1963.

  
Notary Public

My commission expires: 3-17-64