

WELL PLUGGING RECORD

FORMATION PLUGGING RECORD

STATE OF KANSAS  
STATE CORPORATION COMMISSION

Give All Information Completely  
Make Required Affidavit  
Mail or Deliver Report to:  
Conservation Division  
State Corporation Commission  
800 Bitting Building  
Wichita, Kansas

Strike out upper line  
when reporting plug-  
ging of formations.

Barton County, Sec 4 Twp 16 Rge 11 (E) (W)

Location as "NE $\frac{1}{4}$ NW $\frac{1}{4}$ SW $\frac{1}{4}$ " or footage from lines

Lease Owner H.N. Blair

Lease Name Peirano Well No. 3

Office Address Bitting Bldg. Wichita, Kas.

Character of Well (completed as Oil, Gas or Dry Hole) Dry hole

Date well completed July 14 1942

Application for plugging filed " " 1942

Application for plugging approved same day 1942

Plugging commenced July 14 1942


Plugging completed " " 16 1942

Reason for abandonment of well or producing formation 6 bailers water

7 1 bailers oil - few hours.

If a producing well is abandoned, date of last production " " 1942

Was permission obtained from the Conservation Division or its agents before plugging was commenced? Yes

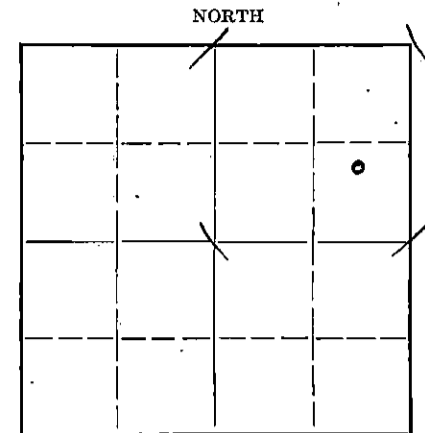

Locate well correctly on above  
Section Plat

Name of Conservation Agent who supervised plugging of this well G.T. Alexander, Great Bend

Producing formation Top Kansas City Depth to top 2995 Bottom 3008 Total Depth of Well 5322 Feet

Show depth and thickness of all water, oil and gas formations.

OIL, GAS OR WATER RECORDS

CASING RECORD

| Formation     | Content       | From | To   | Size   | Put In | Pulled Out |
|---------------|---------------|------|------|--------|--------|------------|
| Sand          | 4 bailers     | 160  | 170  | 12 1/2 | 4 35   | 4 35       |
| "             | H.F.W.        | 325  | 350  | 10"    | 6 85   | 6 85       |
| "             | " "           | 448  | 465  | 8"     | 2400   | 2400       |
| Sand & lime   | 1 1/2 bailers | 1705 | 1720 | 7"     | 2995   | 2874       |
| " of shale    | 1 bailer      | 2365 | 2375 | 5 1/2  | 3260   | 3260       |
| " lime        | " "           | 2645 | 2655 |        |        |            |
| 7 1/2 bailers | Water & oil   | 2995 | 3008 |        |        |            |
| Lime          | More water    | 3074 | 3078 |        |        |            |

Describe in detail the manner in which the well was plugged, indicating where the mud fluid was placed and the method or methods used in introducing it into the hold. If cement or other plugs were used, state the character of same and depth placed, from \_\_\_\_\_ feet to \_\_\_\_\_ feet for each plug set.

Plugged with chat + cement from 3322 to 3015  
pump squeezed off with 56 sacks cement by  
Siber Cement Co. with 1000 pound pressure  
Cement 3015 to 2980, ripped 7" off at 2874  
pulled 7" up 4 joints filled with mud, then  
pulled 7" out 12" + 8" was pulled when 7" was  
cemented at 2995 started 10" filled with mud  
then pulled 10" out. Placed wood plug at  
270 feet with rock on top + cement to 250 ft + mud  
to 18 feet + cement to bottom of well. Pay was  
adjusted with 3000 gal. acid 2995 to 3008. Well was  
swabbed and went to water

PLUGGING  
FILE 30.4 16 11W  
BOOK PAGE 44 LINE 22

STATE OF KANSAS  
CORPORATION COMMISSION  
JUL 28 1942  
CONSERVATION DIVISION  
7-28-42

(If additional description is necessary, use BACK of this sheet)

Correspondence regarding this well should be addressed to H. H. Blair  
Address 600 Bitting Bldg. Wichita, Kas.

STATE OF Kansas, COUNTY OF Barton, ss.

Frank Wood (employee of owner) or (owner or operator) of the above-described well,  
being first duly sworn on oath, says: That I have knowledge of the facts, statements, and matters herein contained and the log of the above-  
described well as filed and that the same are true and correct. So help me God.

(Signature) Frank Wood  
369 West 3rd Hastings Kas. (Address)

SUBSCRIBED AND SWORN to before me this 22 day of July, 1942

Walter M. Smith  
Notary Public.

My commission expires April 25, 1946

H. H. BLAIR, ET AL  
 PEIRANO #3, CN $\frac{1}{2}$  SE/4 NE/4 Sec. 4-16S-11W,  
 Barton County, Kansas

Rigging up commenced 5/21/42  
 Drilling commenced 5/24/42  
 " completed 7/5/42

Drilling contractor: M.B.Armer, Inc.  
 Wichita, Kansas

Elevation 1837'

T.D. 3322' HFW

CASING RECORD:

|                    |             |
|--------------------|-------------|
| 12 $\frac{1}{2}$ " | 443' Pulled |
| 10"                | 685'        |
| 8 $\frac{1}{2}$ "  | 2400'       |
| 7"                 | 2965'       |
| 5"                 | 3260'       |

|                                    |      |
|------------------------------------|------|
| Cellar                             | 8    |
| Post rock                          | 18   |
| Shale blue                         | 110  |
| Sandy shale                        | 150  |
| Lime                               | 160  |
| Sand 4 BW 160-170'                 | 170  |
| Shale blue                         | 215  |
| Red rock                           | 225  |
| Shale blue                         | 240  |
| Red rock & blue shale              | 270  |
| Shale light                        | 280  |
| Red rock                           | 290  |
| Shale blue                         | 310  |
| Sand HFW 325-350'                  | 395  |
| Shale blue 12 $\frac{1}{2}$ " 443' | 448  |
| Sand HFW                           | 465  |
| Shale blue                         | 490  |
| Red rock                           | 505  |
| Red shale                          | 565  |
| Red rock                           | 677  |
| Chalk                              | 680  |
| Lime Anhydrite                     | 705  |
| 10" 685'                           |      |
| Red rock                           | 895  |
| Shale blue                         | 950  |
| Red rock                           | 995  |
| Shale blue                         | 1115 |
| Salt                               | 1355 |
| Shale gray                         | 1370 |
| Lime                               | 1380 |
| Shale                              | 1395 |
| Lime                               | 1405 |
| Shale                              | 1415 |
| Lime                               | 1430 |
| Shale                              | 1440 |
| Lime                               | 1455 |
| Shale red                          | 1465 |
| Shale & shells                     | 1480 |
| Lime                               | 1500 |
| Shale                              | 1510 |
| Lime                               | 1520 |
| Shale                              | 1530 |
| Lime                               | 1565 |
| Shale (red 1575-85)                | 1585 |
| Lime                               | 1625 |
| Shale                              | 1640 |
| Lime                               | 1665 |
| Shale                              | 1675 |
| Lime                               | 1705 |
| Sandy lime 1 $\frac{1}{2}$ BW      | 1720 |
| Lime                               | 1730 |
| Shale                              | 1775 |
| Lime                               | 1790 |
| Shale & shells                     | 1815 |
| Red rock                           | 1825 |
| Lime                               | 1835 |
| Shale                              | 1840 |
| Lime                               | 1860 |

|                            |      |
|----------------------------|------|
| Red rock                   | 1880 |
| Lime                       | 1895 |
| Shale                      | 1905 |
| Lime                       | 1920 |
| Red rock                   | 1925 |
| Lime                       | 1940 |
| Red rock                   | 1945 |
| Lime                       | 1985 |
| Shale                      | 2000 |
| Lime & shale               | 2035 |
| Shale                      | 2050 |
| Lime                       | 2065 |
| Shale                      | 2080 |
| Lime                       | 2100 |
| Shale                      | 2110 |
| Lime                       | 2115 |
| Shale                      | 2120 |
| Lime                       | 2125 |
| Shale                      | 2150 |
| Lime                       | 2155 |
| Shale                      | 2215 |
| Lime                       | 2220 |
| Shale <b>PLUGGING</b>      | 2230 |
| Lime FILE NO. 4-16-11W     | 2235 |
| Shale BOOK PAGE-44-LINE-22 | 2255 |
| Lime                       | 2260 |
| Shale                      | 2335 |
| Lime 1 BW 2365-75'         | 2350 |
| Shale                      | 2390 |
| Lime Set 8" 2400'          | 2410 |
| Shale                      | 2420 |
| Lime                       | 2425 |
| Shale                      | 2435 |
| Lime                       | 2455 |
| Shale                      | 2465 |
| Lime                       | 2480 |
| Shale                      | 2485 |
| Lime                       | 2490 |
| Shale                      | 2530 |
| Lime                       | 2555 |
| Shale                      | 2565 |
| Lime                       | 2645 |
| Lime sandy 1 BWPH          | 2655 |
| Lime 1 BW 2685-2700'       | 2715 |
| Shale                      | 2720 |
| Lime                       | 2725 |
| Shale                      | 2730 |
| Lime                       | 2870 |
| Shale                      | 2875 |
| Lime                       | 2895 |
| Red rock                   | 2900 |
| Lime                       | 2905 |
| Shale                      | 2950 |
| Lime                       | 2960 |
| Red rock                   | 2965 |
| Lime Shp oil 3001-08'      | 3110 |
| Lime sandy 36 BWPH         | 3040 |

(over)

|              |        |            |
|--------------|--------|------------|
| Lime         |        | 3177       |
| Shale        |        | 3182       |
| Lime         |        | 3235       |
| Shale        |        | 3245       |
| Lime         |        | 3251       |
| Shale        |        | 3253       |
| Conglomerate |        | 3260       |
| Lime         | Set 5" | 3260' 3263 |
| Conglomerate |        | 3322 T.D.  |
|              | HFV    | 3322'      |

Plugged back to  
K.C. again tested -  
Nothing but water.