


STATE OF KANSAS
STATE CORPORATION COMMISSION

Form CP-4

WELL PLUGGING RECORD

Give All Information Completely
Make Required Affidavit
Mail or Deliver Report to:
Conservation Division
State Corporation Commission
P. O. Box 17027
Wichita, Kansas 67217
NORTH

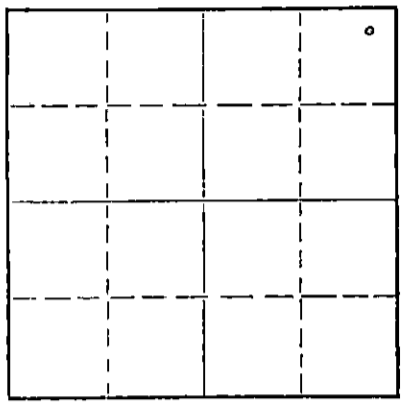

Locate well correctly on above
Section Plat

Barton County. Sec. 4 Twp. 16 Rge. (E) 11 (W)
Location as "NE/CNW/SW" or footage from lines NE NE NE
Lease Owner Duke Drilling Company, Inc.
Lease Name Davidson "B" Well No. 1
Office Address 1105 Williams, Great Bend, Kansas 67530
Character of Well (completed as Oil, Gas or Dry Hole) oil
Date well completed _____ 19____
Application for plugging filed June 27 19 72
Application for plugging approved _____ 19____
Plugging commenced June 29 19 72
Plugging completed July 1 19 72
Reason for abandonment of well or producing formation depleted

If a producing well is abandoned, date of last production _____ 19____
Was permission obtained from the Conservation Division or its agents before plugging was commenced? yes

Name of Conservation Agent who supervised plugging of this well Donald Truan
Producing formation _____ Depth to top _____ Bottom _____ Total Depth of Well 3282 Feet
Show depth and thickness of all water, oil and gas formations.

OIL, GAS OR WATER RECORDS

CASING RECORD

FORMATION	CONTENT	FROM	TO	SIZE	PUT IN	PULLED OUT
		0	502'	8 5/8"	502'	none
		0	2860'	4 1/2"	2860'	2208.58

Describe in detail the manner in which the well was plugged, indicating where the mud fluid was placed and the method or methods used in introducing it into the hole. If cement or other plugs were used, state the character of same and depth placed, from _____ feet to _____ feet for each plug set.

Sanded back to 2800' and dumped 4 sacks of cement.
Set rock bridge at 400'. Plugged well with 6 yards of ready mix cement.

RECEIVED
STATE CORPORATION COMMISSION
JUL 11 1972
7-11-72
CONSERVATION DIVISION
Wichita, Kansas

(If additional description is necessary, use BACK of this sheet)
Name of Plugging Contractor PIPE PULLERS, INC.
Address Box 486, Ellinwood, Kansas 67526

STATE OF KANSAS, COUNTY OF BARTON, ss.
Evelyn Roth (employee of owner) or (owner-or-operator) of the above-described

well, being first duly sworn on oath, says: That I have knowledge of the facts, statements, and matters herein contained and the log of the above-described well as filed and that the same are true and correct. So help me God.

(Signature) Evelyn Roth
Ellinwood, Kansas (Address)

Subscribed and sworn to before me this 10th day of July, 19 72

Aug. 20, 1975

James M. Stemen
Notary Public.

W E L L L O G

Date Commenced: July 14, 1967
 Date Completed: July 21, 1967

Duke Drilling Company
 DAVIDSON B #1
 NE NE NE Sec. 4-16-11w
 Barton County, Kansas

0 - 60' Post Rock Clay
 60 - 500' Shale & Sand
 500 - 675' Red Bed
 675 - 700' Anhydrite
 700 - 1315' Red Bed, Shale
 1315 - 1570' Shale & Shells
 1570 - 1970' Lime Shale
 1970 - 2535' Shale - Lime
 2535 - 2851' Lime
 2851 - 2854' Shale
 2854 - 2882' Lime
 2882 - 2940' Shale & Sand
 2940 - 2955' Lime Shale
 2955 - 3254' Lime
 3254 - 3270' Shale
 3270 - 3282' Quartz

ELEVATION: 1840 K.B.

FORMATION DATA

Anhydrite	675
Heebner	2851
Brown Lime	2940
Lansing	2955
Quartz	3278
RTD	3282

Surface Casing: Set 8-5/8"
 at 502' with 250 sacks cement.

A F F I D A V I T

State of Kansas
 County of Barton) ss.

L. O. Chubb, of lawful age, does swear that the facts and statements herein contained are true and correct to the best of his knowledge.

L. O. Chubb

L. O. Chubb

Subscribed and sworn to before me this 24 day of JULY, 1967.

My Comm. Expires:
April 11, 1970

Dorothy M. Hague
 Notary Public

RECEIVED
 STATE CORPORATIONS COMMISSION
 JUN 28 1972
 CONSERVATION DIVISION
 Wichita, Kansas

State of Kansas
 County of Barton) ss.

Lynn O. Duke, of lawful age, does swear and state the above-named well was later washed down on September 30, 1968, and washed to a total depth of 2960'. Used 4 1/2" casing was set at 2860' with 125 sacks salt sat. Pozmix (50-50).

Lynn O. Duke
 Lynn O. Duke

Subscribed and sworn to before me this 3rd day of October 1968.

My Comm. Expires:
4-11-1970

Dorothy M. Hague
 Notary Public