


STATE OF KANSAS
STATE CORPORATION COMMISSION

WELL PLUGGING RECORD

Give All Information Completely
Make Required Affidavit
Mail or Deliver Report to
Conservation Division
State Corporation Comm.
245 North Water
Wichita, KS 67202

Kingman County, Sec. 26 Twp. 30S Rge. 7 E W
Location as "NE/CNW $\frac{1}{2}$ SW $\frac{1}{2}$ " or footage from lines C NW NW NW

Lease Owner Energy Reserves Group, Inc.
Lease Name Yeager Well No. 15
Office Address 3613 NW 56th, Suite 210, OKC, OK 73112
Character of Well (Completed as Oil, Gas or Dry Hole) Dry Hole

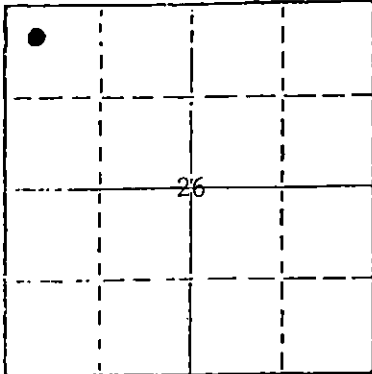

Locate well correctly on above
Section Plot

Date Well completed December 30 1983
Application for plugging filed December 30 1983
Application for plugging approved December 29 1983
Plugging commenced December 29 1983
Plugging completed December 30 1983
Reason for abandonment of well or producing formation no oil or gas
If a producing well is abandoned, date of last production 19

Was permission obtained from the Conservation Division or its agents before plugging was commenced? yes

Name of Conservation Agent who supervised plugging of this well Steve Van Gieson
Producing formation _____ Depth to top _____ Bottom _____ Total Depth of Well 4746
Show depth and thickness of all water, oil and gas formations.

OIL, GAS OR WATER RECORDS

CASING RECORD

FORMATION	CONTENT	FROM	TO	SIZE	PUT IN	PULLED OUT
Lansing	water	surface	248	8-5/8"	239.60	none
Kansas City	water					
Kansas City	water					
Mississippi Chert	water					
Simpson	water					

Describe in detail the manner in which the well was plugged, indicating where the mud fluid was placed and the method or methods used in introducing it into the hold. If cement or other plugs were used, state the character of same and depth placed, from _____ feet to _____ feet for each plug set.

Plug as follows w/Halliburton 60-40 Poz w/2% Gel, 3% CC. With hole full of mud set 1st cmt plug @ 800' w/35 sx. Top of plug approx 700'. Set 2nd cmt plug @ 300' w/35 sx. Top of 2nd plug approx 200'. Set solid 3rd cmt plug from 60' to surface w/35 sx. Pumped 10 sx in rat-hole & mousehole.

(If additional description is necessary, use BACK of this sheet)

Name of Plugging Contractor Slawson Drilling - Drilling Contractor

STATE OF Oklahoma COUNTY OF Oklahoma, ss.
Matt Mollman (employee of owner) or (owner or operator)

of the above-described well, being first duly sworn on oath, says: That I have knowledge of the facts, statements, and matters herein contained and the log of the above-described well as filed and that the same are true and correct. So help me God.

(Signature) Matt Mollman
3613 N.W. 56th, Suite 210, OKC, OK 73112
(Address)

SUBSCRIBED AND SWORN TO before me this 16 day of January, 1984

[Signature]
Notary Public.

My commission expires 2-28-86

RECEIVED
STATE CORPORATION COMMISSION
1-18-84
JAN 18 1984
CONSERVATION DIVISION
Wichita, Kansas