

STATE OF KANSAS
STATE CORPORATION COMMISSION

Form CP-4

WELL PLUGGING RECORD

Give All Information Completely
Make Required Affidavit
Mail or Deliver Report to:
Conservation Division
State Corporation Commission
212 No. Market
Wichita, Kansas

Kingman County, Sec. 25 Twp. 30S Rge. (E) 7W (W)

Location as "NE/CNWxSWx" or footage from lines C-SE/4-SW/4

Lease Owner Amerada Petroleum Corporation

Lease Name Mary Durant Well No. 1

Office Address Box 197, Great Bend, Kansas-67530

Character of Well (completed as Oil, Gas or Dry Hole) Dry Hole

Date well completed 1-21 1966

Application for plugging filed 1-22 1966

Application for plugging approved 1-24 1966


Plugging commenced 6:45 a.m. 1-21 1966

Plugging completed 7:45 a.m. 1-21 1966

Reason for abandonment of well or producing formation Dry Hole

If a producing well is abandoned, date of last production - 19-

Was permission obtained from the Conservation Division or its agents before plugging was commenced? Yes

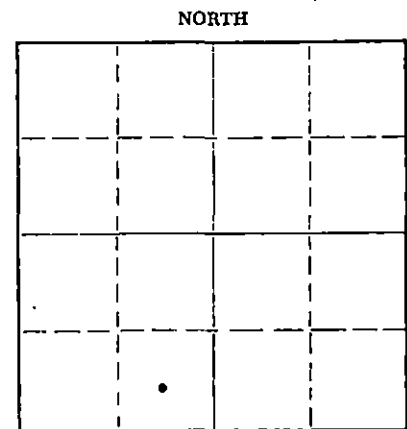

Locate well correctly on above Section Plat

Name of Conservation Agent who supervised plugging of this well Archie Elving, Pratt, Kansas

Producing formation _____ Depth to top _____ Bottom _____ Total Depth of Well 4719 Feet

Show depth and thickness of all water, oil and gas formations.

OIL, GAS OR WATER RECORDS

CASING RECORD

FORMATION	CONTENT	FROM	TO	SIZE	PUT IN	PULLED OUT
				8-5/8"	246'	None

Describe in detail the manner in which the well was plugged, indicating where the mud fluid was placed and the method or methods used in introducing it into the hole. If cement or other plugs were used, state the character of same and depth placed, from _____ feet to _____ feet for each plug set.

Filled Hole with Heavy Mud from 4719' to 250'. Bridged with 1 Sack Dry Cement and 1/2 Sack Hulls. Globe Cementers Spotted Cement Plug from 250' to 175' with 25 Sacks Cement. Filled hole with heavy mud from 175' to 40'. Globe Cementers Spotted Cement Plug from 40' to bottom of cellar with 10 Sacks Cement. Dumped 2 Sacks Cement in Rat Hole.

RECEIVED
STATE CORPORATION COMMISSION
1-28-66
JAN 28 1966

(If additional description is necessary, use BACK of this sheet)

Name of Plugging Contractor Rains and Williamson Oil Company, 1425 Wichita Plaza, Wichita, Kansas
Address _____

STATE OF Kansas, COUNTY OF Barton, ss. C.E. Richardson (employee of owner) ~~or (owner/operator)~~

well, being first duly sworn on oath, says: That I have knowledge of the facts, statements, and matters herein contained and the log of the above-described well as filed and that the same are true and correct. So help me God.

(Signature) C.E. Richardson Farm Boss:
Box 197, Great Bend, Kansas-67530
(Address)

SUBSCRIBED AND SWORN TO before me this 27 day of January 19 66

My commission expires November 21, 1969 Charles W. Anderson Notary Public.

25-30-7W

AP

ROTARY DRILLING LOG 15-095-30072-0000

Operator: Amerada Petroleum Corp.
#1 Mary Durant
C SE SW Sec. 25-30S-7W
Kingman Co., Kansas

Contractor: Rains & Williamson Oil Co.
Commenced: 12-31-65
Completed: 1-21-66

Remarks: Set 246' of 8-5/8" surface casing with 200 sx cement

Formations

Surface clay & soil	15'
Sand	55'
Shale & Red Bed	255'
Red Bed & Shale	1174'
Anhydrite	1205'
Shale & Lime	1450'
Lime & Shale	1823'
Shale & Lime	3070'
Lime & Shale	3224'
Shale & Lime	3295'
Lime & Shale	3800'
Lime	4055'
Lime & Shale	4135'
Lime	4197'
Lime, Shale & Sand	4280'
Lime & Shale	4312'
Lime	4387'
Lime & Chert	4460'
Lime	4580'
Shale & Lime	4712'
Sand	4719'
Rotary Total Depth (D&A)	4719'

RECEIVED
STATE CORPORATION COMMISSION

JAN 28 1966

TRANSFERRED TO THE RECORDS OF THE STATE CORPORATION COMMISSION
JAN 28 1966

We certify the above log is true and correct to the best of our knowledge and belief.

RAINS & WILLIAMSON OIL CO.

Wilson Rains
Wilson Rains, Partner

Subscribed and sworn to before me, a Notary Public in and for the State of Kansas, County, of Sedgwick, this 25th day of January, 1966.

My Commission Expires:
July 25, 1968

Judith Caughlin
Judith Caughlin, Notary Public