


STATE OF KANSAS  
STATE CORPORATION COMMISSION

Form CP-4

WELL PLUGGING RECORD

Give All Information Completely  
Make Required Affidavit  
Mail or Deliver Report to:  
Conservation Division  
State Corporation Commission  
212 No. Market  
Wichita, Kansas

NORTH

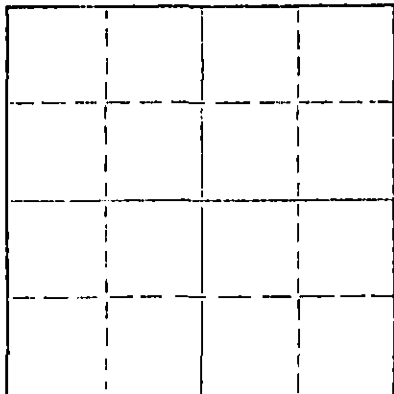

Locate well correctly on above  
Section Plat

Kingman County, Sec. 25 Twp. 30S Rge. (E) 7W (W)  
Location as "NE/CNW/SW" or footage from lines APPROX NE SE  
Lease Owner Thornton E. Anderson  
Lease Name Lechner Well No. 2  
Office Address 710 Union Nat'l Bldg., Wichita, Kansas  
Character of Well (completed as Oil, Gas or Dry Hole) Dry Hole  
Date well completed 2-21 19 72  
Application for plugging filed 2-21 19 72  
Application for plugging approved 2-21 19 72  
Plugging commenced 2-21 19 72  
Plugging completed 2-21 19 72  
Reason for abandonment of well or producing formation No commercial quantities of oil or gas encountered.  
If a producing well is abandoned, date of last production 19  
Was permission obtained from the Conservation Division or its agents before plugging was commenced? Yes

Name of Conservation Agent who supervised plugging of this well G. Russel Biberstein  
Producing formation \_\_\_\_\_ Depth to top \_\_\_\_\_ Bottom \_\_\_\_\_ Total Depth of Well 4692 Feet  
Show depth and thickness of all water, oil and gas formations.

OIL, GAS OR WATER RECORDS

CASING RECORD

FORMATION	CONTENT	FROM	TO	SIZE	PUT IN	PULLED OUT
Surface Hole	Water	Surface	230'	8-5/8"	230'	None

Describe in detail the manner in which the well was plugged, indicating where the mud fluid was placed and the method or methods used in introducing it into the hole. If cement or other plugs were used, state the character of same and depth placed, from \_\_\_\_\_ feet to \_\_\_\_\_ feet for each plug set.

Fluid to 220, plug, 25 sx cement;  
Fluid to 40, plug, 10 sx cement;  
Two sacks cement in rat hole.

2-23-72  
RECEIVED  
STATE CORPORATION COMMISSION  
FEB 23 1972  
CONSERVATION DIVISION  
Wichita, Kansas


(If additional description is necessary, use BACK of this sheet)  
Name of Plugging Contractor D N B DRILLING, INC.  
Address 737 First Nat'l Bank Bldg., Wichita, Kansas 67202

STATE OF KANSAS, COUNTY OF \_\_\_\_\_, ss.  
JAMES L. DONELSON (employee of owner) or (owner or operator) of the above-described

well, being first duly sworn on oath, says: That I have knowledge of the facts, statements, and matters herein contained and the log of the above-described well as filed and that the same are true and correct. So help me God.

(Signature) James L. Donelson  
737 First Nat'l Bk Bldg., Wichita, Ks.  
(Address)

Subscribed and Sworn to before me this 22nd day of February, 19 72

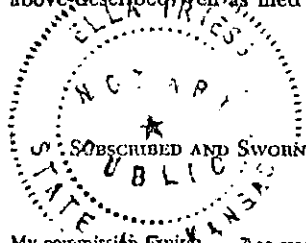

Ella Priess  
Notary Public

My commission expires August 25, 1972

DRILLERS' LOG

THORNTON E. ANDERSON  
No. 2 Lechner  
NE SE, Sec. 25-30S-7W  
Kingman County, Kansas

Elevation: 1565 R.B.

Commenced: 2- 9-72  
Completed: 2-21-72

Surface Casing: 230' of  
8-5/8" Surface Casing  
cemented w/250. sx cement.  
2-10-72

<u>FORMATION</u>	<u>DEPTH</u>
Surface Hole	236
Shale	407
Shale & Salt	1140
Lime & Shale	1387
Shale & Lime	1599
Lime & Shale	2007
Shale & Lime	2231
Lime & Shale	2614
Shale & Lime	2847
Lime	3315
Shale & Lime	3520
Sand	3548
Shale & Lime	3738
Lime	4237
Shale & Lime	4270
Cherty Lime	4295
Lime	4537
Lime & Shale	4692 T.D.

RECEIVED  
STATE CORPORATION COMMISSION  
FEB 23 1972  
CONSERVATION DIVISION  
Wichita, Kansas

I do hereby certify that the foregoing statements are true and correct to the best of my knowledge and belief.

D N B DRILLING, INC.

*James L. Donelson*  
JAMES L. DONELSON

STATE OF KANSAS: ss:

Subscribed and sworn to before me, the undersigned, a Notary Public in and for said state, this 21st day of February, 1972

My Commission Expires:  
August 25, 1972

*Ella Priess*  
Ella Priess, Notary Public

