


STATE OF KANSAS  
STATE CORPORATION COMMISSION

Give All Information Completely  
Make Required Affidavit  
Mail or Deliver Report to:  
Conservation Division  
State Corporation Commission  
P. O. Box 17027  
Wichita, Kansas 67217  
NORTH

WELL PLUGGING RECORD

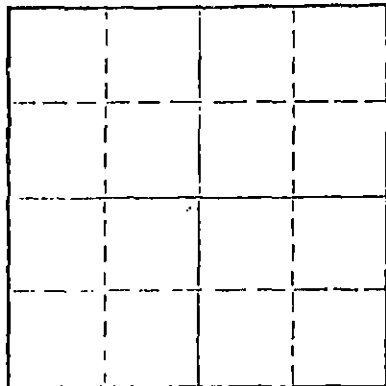

Locate well correctly on above  
Section Plat

Kingman County, Sec. 32 Twp. 30S Rge. 7W (E) (W)  
Location as "NE/CNW4SW4" or footage from lines 100-N-N-SE NE  
Lease Owner SeRoBee Drilling Co., Inc. & Shaffer Oil Co.  
Lease Name Hunter Well No.  
Office Address 256 North Topeka, Wichita, Kansas 67202  
Character of Well (completed as Oil, Gas or Dry Hole) Gas  
Date well completed Sept. 21, 19 72  
Application for plugging filed August 4, 19 75  
Application for plugging approved August 6, 19 75  
Plugging commenced August 7, 19 75  
Plugging completed August 9, 19 75  
Reason for abandonment of well or producing formation  
Not Productive  
If a producing well is abandoned, date of last production July 1, 19 75  
Was permission obtained from the Conservation Division or its agents before plugging was commenced? Yes

Name of Conservation Agent who supervised plugging of this well Russell Biberstien  
Producing formation Miss. Depth to top Bottom Total Depth of Well 4366 Feet  
Show depth and thickness of all water, oil and gas formations.

OIL, GAS OR WATER RECORDS

CASING RECORD

FORMATION	CONTENT	FROM	TO	SIZE	PUT IN	PULLED OUT
				8 5/8	223	None
				5 1/2	4356	3200

Describe in detail the manner in which the well was plugged, indicating where the mud fluid was placed and the method or methods used in introducing it into the hole. If cement or other plugs were used, state the character of same and depth placed, from feet to feet for each plug set.

Sand from 4366 to 4345'  
Cement 5 sacks from 4345 to 4315'  
Wooden Bridge at 360'  
Rock from 360 to 350'  
6 yards of ready mix to top

RECEIVED  
STATE CORPORATION COMMISSION  
8-18-75  
AUG 18 1975  
CONSERVATION DIVISION  
Wichita, Kansas

Name of Plugging Contractor Clarke Corporation  
Address Box 187, Medicine Lodge, Kansas 67104

STATE OF Kansas COUNTY OF Barber ss.  
Elmo Morgenstern

(employee of owner) or (owner or operator) of the above-described well, being first duly sworn on oath, says: That I have knowledge of the facts, statements, and matters herein contained and the log of the above-described well as filed and that the same are true and correct. So help me God.

(Signature) Elmo Morgenstern  
Medicine Lodge, Kansas 67104  
(Address)

Subscribed and sworn to before me this 14th day of August, 19 75

Jessie Hamilton  
Notary Public.

My commission expires April 4, 1978.

ROTARY DRILLERS' LOG

OPERATOR: SeRoBee Drilling Co. DRILLING COMMENCED: September 14, 1973  
and Shaffer Oil Co.  
256 North Topeka  
Wichita, Kansas 67202

CONTRACTOR: Graves Drilling Co., Inc. DRILLING COMPLETED: September 21, 1973  
505 Union Center  
Wichita, Kansas 67202

CASING RECORD: 5 Jts. 223' 8-5/8" LOCATION: Hunter No. 1  
cemented with 235 sacks. 100' N of SE NE  
139 Jts. 4356' 5-1/2" Section 32-30S, 7W  
cemented with 100 sacks. Kingman County, Kansas

-----

0 - 40	Clay & sand
40 - 223	Sand & red bed
223 - 1230	Shale & shells
1230 - 1965	Shale & lime
1965 - 2200	Lime
2200 - 2495	Lime & shale
2495 - 3195	Shale & lime
3195 - 3390	Lime
3390 - 3650	Shale & lime
3650 - 4070	Lime
4070 - 4175	Shale & lime
4175 - 4350	Lime
4350 - 4354	Shale
4354 - 4366	Chert
4366	Rotary Total Depth

RECEIVED  
STATE CORPORATION COMMISSION  
AUG 11 1975  
CONSERVATION DIVISION  
Wichita, Kansas

I hereby certify the foregoing statements to be true and correct to the best of my knowledge.

GRAVES DRILLING CO., INC.

By *Phil Graves*  
President

STATE OF KANSAS )  
                          ) ss.  
SEDGWICK COUNTY )

Subscribed and sworn to before me, a Notary Public, this 24th of September, 1973.

*Betty Brandt*  
Betty Brandt Notary Public

My commission expires:  
May 9, 1975

*Copy to Corporation Commission*  
*Copy to Bill dog Bureau*