


STATE OF KANSAS  
STATE CORPORATION COMMISSION

WELL PLUGGING RECORD

Give All Information Completely  
Make Required Affidavit  
Mail or Deliver Report to  
Conservation Division  
State Corporation Comm.  
245 North Water  
Wichita, KS 67202

KINGMAN County, Sec. 32 Twp. 30S Rge. 7W E/W  
Location as "NE/CNW 1/4 SW 1/4" or footage from lines

NE NE NE  
Lease Owner PICKRELL DRILLING COMPANY  
Lease Name HUNTER "C" Well No. 1  
Office Address 205 LITWIN BLDG., WICHITA, KS. 67202  
Character of Well (Completed as Oil, Gas or Dry Hole)

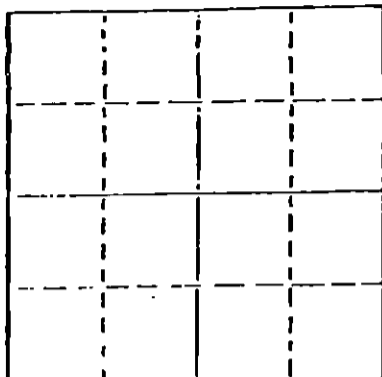

Locate well correctly on above Section Plot

Dry Hole  
Date Well completed 7-11-77 19  
Application for plugging filed 7-11-77 19  
Application for plugging approved 7-11-77 19  
Plugging commenced 7-11-77 19  
Plugging completed 7-11-77 19  
Reason for abandonment of well or producing formation  
Dry Hole  
If a producing well is abandoned, date of last production 19

Was permission obtained from the Conservation Division or its agents before plugging was commenced? Yes

Name of Conservation Agent who supervised plugging of this well Jasper Metz  
Producing formation Depth to top Bottom Total Depth of Well 4785  
Show depth and thickness of all water, oil and gas formations.

OIL, GAS OR WATER RECORDS

CASING RECORD

| FORMATION | CONTENT | FROM | TO | SIZE  | PUT IN | PULLED OUT |
|-----------|---------|------|----|-------|--------|------------|
|           |         |      |    | 8 5/8 | 213    | None       |
|           |         |      |    |       |        |            |
|           |         |      |    |       |        |            |
|           |         |      |    |       |        |            |

Describe in detail the manner in which the well was plugged, indicating where the mud fluid was placed and the method or methods used in introducing it into the hold. If cement or other plugs were used, state the character of same and depth placed, from feet to feet for each plug set.

RECEIVED  
JUL 19 1977  
CONSERVATION DIVISION  
WICHITA, KANSAS

40 sacks at 210'  
10 sacks at 40'  
5 sacks in Rat Hole Comp. 1AM 7-11-77

7-19-77

(If additional description is necessary, use BACK of this sheet)

Name of Plugging Contractor PICKRELL DRILLING COMPANY

STATE OF Kansas COUNTY OF Sedgwick, ss.  
C. W. Sebitts (employee of owner) or (owner or operator)  
of the above-described well, being first duly sworn on oath, says: That I have knowledge of the facts, statements, and matters herein contained and the log of the above-described well as filed and that the same are true and correct. So help me God.

BY: C. W. Sebitts  
(Signature) [Signature]  
205 LITWIN BLDG., WICHITA, KS. 67202  
(Address)

SUBSCRIBED AND SWORN TO before me this 15 day of July, 1977

[Signature]  
Jo Ann Sarver  
Notary Public.

My commission expires



**ROTARY DRILLING LOG**

COMPANY: PICKRELL DRILLING COMPANY  
205 LITWIN BLDG.  
WICHITA, KS. 67202  
LOCATION: HUNTER "C" #1  
NE NE NE 32-30S-7W  
KINGMAN CO., KS.  
CONTRACTOR: **PICKRELL DRILLING COMPANY**  
Wichita, Kansas

Rotary Drilling Commenced 6-29-77  
Rotary Drilling Completed 7-11-77

CASING RECORD: 8 5/8 Surface casing set at 213' with 160 sx. Comp. 6-29-77 9:00PM

**LOG**

(Figures indicate bottom of formation — measurements from top of rotary bushing.)

|              |      |
|--------------|------|
| Sand         | 100  |
| Red Rock     | 215  |
| Shale        | 440  |
| Shale        | 1360 |
| Shale        | 1590 |
| Shale & Lime | 1845 |
| Lime & Shale | 2070 |
| Shale & Lime | 2260 |
| Lime & Shale | 2515 |
| Lime & Shale | 2705 |
| Shale & Lime | 2960 |
| Shale & Lime | 3210 |
| Lime         | 3375 |
| Lime         | 3505 |
| Lime         | 3635 |
| Lime         | 3725 |
| Lime         | 3835 |
| Lime         | 3955 |
| Lime & Shale | 4050 |
| Shale & Lime | 4140 |
| Lime         | 4230 |
| Lime         | 4315 |
| Lime         | 4355 |
| Lime         | 4366 |
| Lime         | 4415 |
| Lime         | 4530 |
| Lime         | 4585 |
| Lime         | 4645 |
| Shale & Lime | 4720 |
| Lime         | 4751 |
| Lime - RTD   | 4785 |

RECEIVED  
JUL 19 1977  
CONSERVATION DIVISION  
Wichita, Kansas

The undersigned, C. W. Sebitts, Attorney-in-Fact for PICKRELL DRILLING COMPANY, hereby certifies in behalf of said Company, that the above is a true and correct log of the formation encountered in drilling the above well as reflected by the Daily Drilling Reports.

PICKRELL DRILLING COMPANY

By [Signature]  
Attorney-in-Fact  
C. W. Sebitts

STATE OF KANSAS }  
COUNTY OF SEDGWICK } ss.:

On this 15 day of July, 19 77, before me the undersigned, a Notary Public, in and for the County and State aforesaid, personally appeared C. W. Sebitts, to me known to be the identical person who subscribed the name of PICKRELL DRILLING COMPANY to the foregoing instrument as its Attorney-in-Fact and acknowledged to me that he executed the same as his free and voluntary act and deed, and as the free and voluntary act and deed of such company, for the uses and purposes therein set forth.

Given under my hand and seal of office the day and year last above written.

My commission expires: \_\_\_\_\_

[Signature]  
Notary Public  
Jo Ann Sarver

