


STATE OF KANSAS
STATE CORPORATION COMMISSION

Give All Information Completely
Make Required Affidavits
Mail or Deliver Report to:
Conservation Division
State Corporation Commission
212 No. Market
Wichita, Kansas

WELL PLUGGING RECORD

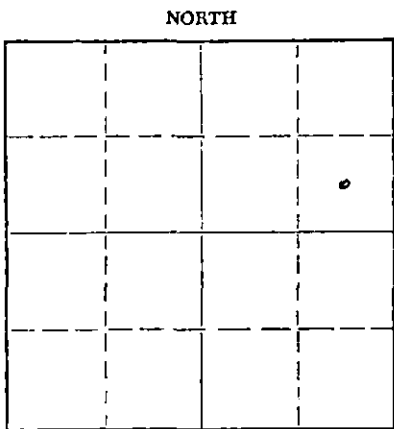

Locate well correctly on above
Section Plat

Kingman County. Sec. 32 Twp. 30 Rge. 7 (E) W (W)
Location as "NE/CNW/SW" or footage from lines SE NE
Lease Owner Beardmore Drilling Co.
Lease Name Hunter Well No. 1
Office Address 700-One-Twenty Bldg., Wichita, Kansas
Character of Well (completed as Oil, Gas or Dry Hole) Dry Hole
Date well completed 10-27 1967
Application for plugging filed 10-27-61967
Application for plugging approved 10-27 1967
Plugging commenced 10-27 1967
Plugging completed 10-27 1967
Reason for abandonment of well or producing formation Dry Hole
If a producing well is abandoned, date of last production 19
Was permission obtained from the Conservation Division or its agents before plugging was commenced? Yes

Name of Conservation Agent who supervised plugging of this well Archie Elving
Producing formation Depth to top Bottom Total Depth of Well Feet
Show depth and thickness of all water, oil and gas formations.

OIL, GAS OR WATER RECORDS				CASING RECORD		
FORMATION	CONTENT	FROM	TO	SIZE	PUT IN	PULLED OUT
Surface Pipe		-0-	205	8 5/8"	205	-0-

Describe in detail the manner in which the well was plugged, indicating where the mud fluid was placed and the method or methods used in introducing it into the hole. If cement or other plugs were used, state the character of same and depth placed, from feet to feet for each plug set.

Filled hole with heavy mud.
#1 plug @ 200 feet with 25 sks. cement
#2 plug @ 40 feet with 10 sks. Cement
#3 plug in rat hole with 2 sks. cement.


RECEIVED
STATE CORPORATION COMMISSION
NOV 2 1967
CONSERVATION DIVISION
WICHITA, KANSAS

(If additional description is necessary, use BACK of this sheet)
Name of Plugging Contractor Sweetman Drilling, Inc.
Address Box 645, Great Bend, Kansas 67530

STATE OF Kansas, COUNTY OF Barton, ss.
T. D. Sweetman (employee of owner) or (owner or operator) of the above-described well, being first duly sworn on oath, says: That I have knowledge of the facts, statements, and matters herein contained and the log of the above-described well as filed and that the same are true and correct. So help me God.

(Signature) T. D. Sweetman
Box 645, Great Bend, Kansas 67530
(Address)

Subscribed and sworn to before me this 30 day of October, 1967
My commission expires 5-9-71
Notary Public.

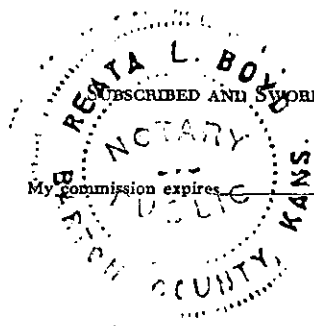

15-095-20048-0000

WELL LOG
Hunter #1
SE NE 32-30-7W
Kingman County, Kansas

Elevation: 1634' K. B.

FROM	TO
0	25
25	100
100	1326
1326	1528
1528	3368

Clay
Sand
Shale
Anhydrite
Lime & Shale
Total Depth

RECEIVED
STATE GEOLOGICAL SURVEY

NOV 2 1967

11-2-67

CONSERVATION DIVISION
Wichita, Kansas

STATE OF KANSAS
COUNTY OF BARTON ss

T. D. Sweetman, Partner of Sweetman Drilling, Inc., being first
duly sworn, says: That I have knowledge of the facts, statements and
matters herein contained and the log of the above described well as filed and
that the same are true and correct.

T. D. Sweetman
T. D. Sweetman

Subscribed and sworn before me this 30th day of October, 1967

Reata L. Boyd
Notary Public
Barton County

