


STATE OF KANSAS
STATE CORPORATION COMMISSION

Give All Information Completely
Make Required Affidavit
Mail or Deliver Report to:
Conservation Division
State Corporation Commission
212 No. Market
Wichita, Kansas

WELL PLUGGING RECORD

Kingman County. Sec. 33 Twp. 30 Rge. 7 (E) (W) x
Location as "NE/CNWxSWx" or footage from lines SW NE

Lease Owner McClure Oil Co.
Lease Name Wells Well No. #1
Office Address 1301 Wichita Plaza, Wichita, Kansas
Character of Well (completed as Oil, Gas or Dry Hole)
Date well completed 19
Application for plugging filed 19
Application for plugging approved 19
Plugging commenced 5-20-66 19
Plugging completed 5-31-66 19
Reason for abandonment of well or producing formation

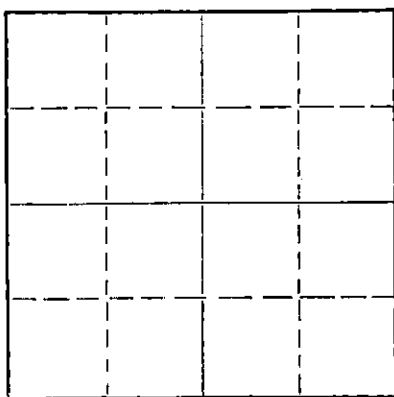

Locate well correctly on above
Section Plat

If a producing well is abandoned, date of last production 19
Was permission obtained from the Conservation Division or its agents before plugging was commenced?

Name of Conservation Agent who supervised plugging of this well Archie Elving
Producing formation Depth to top Bottom Total Depth of Well 4745' Feet
Show depth and thickness of all water, oil and gas formations.

OIL, GAS OR WATER RECORDS

CASING RECORD

FORMATION	CONTENT	FROM	TO	SIZE	PUT IN	PULLED OUT

Describe in detail the manner in which the well was plugged, indicating where the mud fluid was placed and the method or methods used in introducing it into the hole. If cement or other plugs were used, state the character of same and depth placed, from feet to feet for each plug set.

Made bottom hole plug back with sand to 4135', mixed and ran 5 sacks cement thru dump bailer.
Mudded hole to 300' - set 20' rock bridge. Filled hole with 4 yards Ready-Mix.

RECEIVED
STATE CORPORATION COMMISSION

JUN - 2 1966
6-2-66
CONSERVATION DIVISION
Wichita, Kansas

(If additional description is necessary, use BACK of this sheet)

Name of Plugging Contractor Southwest Casing Pulling Co., Inc.
Address Box 364, Great Bend, Kansas

STATE OF Kansas, COUNTY OF Barton, ss.
Southwest Casing Pulling Co., Inc. (employee of owner) or (owner or operator) of the above-described well, being first duly sworn on oath, says: That I have knowledge of the facts, statements, and matters herein contained and the log of the above-described well as filed and that the same are true and correct. So help me God.

(Signature) W. C. Spencer
Box 364, Great Bend, Kansas
(Address)

SUBSCRIBED AND SWORN TO before me this 1 day of June, 19 66

My commission expires 24 October 1968

Sidney D. Miller
Notary Public.

ROTARY DRILLING LOG

KERO COPY KERO COPY KERO COPY

15-095-30082-0000

Operator: McClure Oil Company
 #1 Wells
 C SW NE Section 33-30S-7W
 Kingman County, Kansas

Contractor: Rains & Williamson Oil Co.
 Commenced: 1-22-66
 Completed: 2-5-66

Remarks: Set 258' of 8-5/8" surface casing with 200 sacks Oklahoma Portland cement.
 Set 5 1/2" casing 2' off bottom with 100 sacks 50-50 ports.

FORMATIONS:

Surface Soil & Clay	35'
Sand	92'
Shale & Shells	150'
Shale & Red Bed	265'
Cement	265'
Red Bed & Shale	1227'
Anhydrite	1238'
Shale & Shells	1365'
Shale & Lime Stks.	1475'
Lime & Shale	1840'
Shale & Lime	2333'
Lime & Shale	2850'
Shale	2995'
Lime & Shale	3875'
Lime	4070'
Lime & Shale	4345'
Miss. Lime	4365'
Lime - Chert	4410'
Lime	4525'
Lime & Chert	4570'
Lime	4622'
Shale	4710'
Sand	4715'
Shale	4745'
Rotary Total Depth	4745'

RECEIVED
 STATE CORPORATION COMMISSION
 JUN - 3 - 1966
 CONSERVATION DIVISION
 Wichita, Kansas

We certify the above log is true and correct to the best of our knowledge and belief.

RAINS & WILLIAMSON OIL CO.

Wilson Rains
 Wilson Rains, Partner

Subscribed and sworn to before me, a Notary Public in and for the State of Kansas, County of Sedgwick, this 8th day of February, 1966.

My Commission Expires:
 January 8, 1968

Shirley Beck
 Shirley Beck, Notary Public