


STATE OF KANSAS  
STATE CORPORATION COMMISSION

WELL PLUGGING RECORD

Give All Information Completely  
Make Required Affidavit  
Mail or Deliver Report to  
Conservation Division  
State Corporation Comm.  
245 North Water  
Wichita, KS 67202

Kingman County. Sec. 36 Twp. 30 Rge. 7 E/W  
Location as "NE/CNW1SW1" or footage from lines  
C E/2-SW C S E W.

Lease Owner Rains & Williamson Oil Co.  
Lease Name Russell A#1 Well No. \_\_\_\_\_  
Office Address Wichita, Kansas 67202  
Character of Well (Completed as Oil, Gas or Dry Hole) \_\_\_\_\_

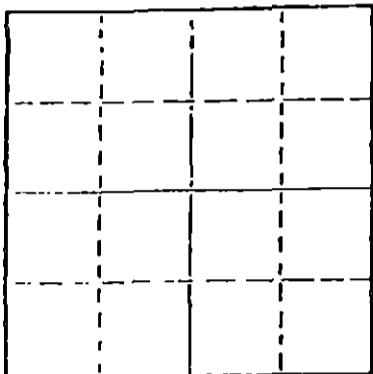

Locate well correctly on above  
Section Plot

Date Well completed \_\_\_\_\_ 19\_\_\_\_  
Application for plugging filed \_\_\_\_\_ 19\_\_\_\_  
Application for plugging approved \_\_\_\_\_ 19\_\_\_\_  
Plugging commenced 9/18/79 \_\_\_\_\_ 19\_\_\_\_  
Plugging completed 9/21/79 \_\_\_\_\_ 19\_\_\_\_  
Reason for abandonment of well or producing formation  
depleted.

If a producing well is abandoned, date of last production  
\_\_\_\_\_ 19\_\_\_\_

Was permission obtained from the Conservation Division or  
its agents before plugging was commenced? yes

Name of Conservation Agent who supervised plugging of this well Owens  
Producing formation \_\_\_\_\_ Depth to top \_\_\_\_\_ Bottom \_\_\_\_\_ Total Depth of Well 4714  
Show depth and thickness of all water, oil and gas formations.

OIL, GAS OR WATER RECORDS

CASING RECORD

FORMATION	CONTENT	FROM	TO	SIZE	PUT IN	PULLED OUT
				8-5/8	309	none
				5 1/2"	4709	3736'

Describe in detail the manner in which the well was plugged, indicating where the mud fluid  
was placed and the method or methods used in introducing it into the hold. If cement or other  
plugs were used, state the character of same and depth placed, from \_\_\_\_\_ feet to  
\_\_\_\_\_ feet for each plug set.

Pushed plug to 4400', sand from 4400 to 4350' and ran 5 sacks cement. Shot pipe at  
3715', pulled 117 joints. Squeezed hole with 4 sacks hulls, 25 sacks cement, 3 sacks  
hulls and 25 sacks gel. Released plug and displaced with 1 sack hulls, 150 sacks  
50-50 pozmix, 4% gel and 3% cc.

PLUGGING COMPLETE.

RECEIVED  
STATE CORPORATION COMMISSION  
10-4-79  
OCT - 4 1979

(If additional description is necessary, use BACK of this sheet)

Name of Plugging Contractor KELSO CASING PULLING  
CHASE, KANSAS

STATE OF KANSAS COUNTY OF RICE, ss.  
R. DARRELL KELSO (employee of owner) or (owner or operator)  
of the above-described well, being first duly sworn on oath, says: That I have knowledge of  
the facts, statements, and matters herein contained and the log of the above-described well  
as filed and that the same are true and correct. So help me God.

(Signature) R. Darrell Kelso  
CHASE, KANSAS

(Address)

SUBSCRIBED AND SWORN TO before me this 27th day of Sept., 19 79

Margaret Melcher  
Notary Public.

My commission expires \_\_\_\_\_



RAINS & WILLIAMS - Operator

SIERRA PETROLEUM CO., INC. - Contractor

RUSSELL #1  
C-57 54  
Sec. 36-303-74  
Kingman County, Kansas

T. D. # 4714  
Elev. = 1774' E.B.

Commenced: 2-21-65  
Completed: 3-6-65

Casing:  
3-3/8" Set at 209'  
5-1/2" Set at 4709'

Cement:  
with 175 ex. cement w/ GL-2  
with 150 ex. pozzol

FORMATION	DEPTH
Clay & Sand	95
Redbed	209
Shale & Redbed	1025
Shale & Shale	1525
Lime & Shale	1924
Shale & Shale	2315
Shale & Lime	3811
Lime	4315
Lime & Chert	4360
Mississippi Chert	4425
Chert	4584
Shale & Lime	4714

STATE OF KANSAS )  
COUNTY OF RUSSELL ) Sst

I hereby certify that the above information is true and correct to the best of my knowledge.

*G. A. Hall*  
G. A. HALL  
Production Superintendent

Subscribed and sworn to before me this 16th day of March, 1965.

*Luis Ortiz*  
Notary Public

My commission expires: 10-17-67

STATE RECEIVED  
COMMISSION  
SEP 18 1970



HADES & WILLIAMSON - Operator

SINRA PETROLEUM CO., INC. - Contractor

RUSSELL #1  
C 55 SW  
Sec. 36-503-7W  
Kingman County, Kansas

T. D.: 4714'  
Elev.: 1594' K.B.

Commenced: 2-21-65  
Completed: 3-6-65

Casing:

3-5/8" Set at 209'  
5-1/2" Set at 4709 1/2'

Content:

with 175 sz. common w/ 01-3  
with 150 sz. potash

FORMATION	DEPTH
Clay & Sand	95
Redbed	209
Shale & Redbed	2025
Shale & Shells	1325
Lime & Shale	1924
Shale & Shells	2315
Shale & Lime	3844
Lime	4345
Lime & Chert	4360
Mississippi Chert	4425
Chert	4584
Shale & Lime	4714

RECEIVED  
STATE CORPORATION COMMISSION

FEB 25 1975

CONSERVATION DIVISION  
Wichita, Kansas

STATE OF KANSAS }  
COUNTY OF RUSSELL }     ss:

I hereby certify that the above information is true and correct to the best of my knowledge.

*J. A. Hall*  
G. A. HALL  
Production Superintendent

Subscribed and sworn to before me this 16th day of March, 1965.

*Leroy Ditty*  
Notary Public

My commission expires: 10-17-67

*No perforations*

