


WELL PLUGGING RECORD

Give All Information Completely
Make Required Affidavit
Mail or Deliver Report to:
Conservation Division
State Corporation Commission
212 No. Market
Wichita, Kansas

NORTH

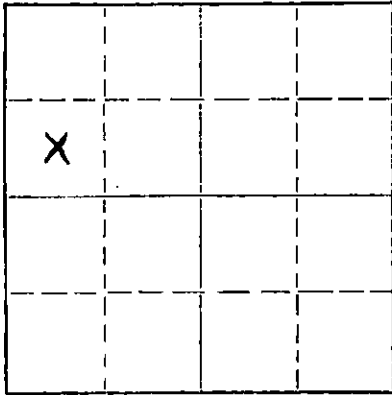

Locate well correctly on above
Section Plat

Kingman County, Sec. 36 Twp. 30S Rge. 7 (E) W (W)
Location as "NE/CNW/SW" or footage from lines C SW NW
Lease Owner Rains & Williamson Oil Co., Inc.

Lease Name Lechner A Well No. 1
Office Address 1425 Wichita Plaza Wichita, Kansas

Character of Well (completed as Oil, Gas or Dry Hole) Oil

Date well completed _____ 19____
Application for plugging filed 4 - 18 19 69
Application for plugging approved 4 - 21 19 69
Plugging commenced 4 - 19 19 69
Plugging completed 4 - 23 19 69

Reason for abandonment of well or producing formation _____

If a producing well is abandoned, date of last production _____ 19____

Was permission obtained from the Conservation Division or its agents before plugging was commenced? YES

Name of Conservation Agent who supervised plugging of this well Ralph Warren

Producing formation _____ Depth to top _____ Bottom _____ Total Depth of Well _____ Feet

Show depth and thickness of all water, oil and gas formations.

OIL, GAS OR WATER RECORDS				CASING RECORD		
FORMATION	CONTENT	FROM	TO	SIZE	PUT IN	PULLED OUT
				8 5/8	222	none
				5 1/2	4732	3302
RECEIVED STATE CORPORATION COMMISSION MAY 5 1969 CONSERVATION DIVISION Wichita, Kansas S-5-69						

Describe in detail the manner in which the well was plugged, indicating where the mud fluid was placed and the method or methods used in introducing it into the hole. If cement or other plugs were used, state the character of same and depth placed, from _____ feet to _____ feet for each plug set.

Plugged back with sand to 4720'. Mixed and dumped 5 sx of cement from 4720' to 4680'. Pulled casing. Mudded hole to 210'. Set 10' rock bridge from 210' to 200'. Mixed and dumped 25 sx of cement from 200' to 125'. Mudded casing to 40'. Set 10' rock bridge from 40' to 30'. Mixed and dumped 10 sx of cement from 30' to base of cellar.

(If additional description is necessary, use BACK of this sheet)
Name of Plugging Contractor Russ Casing Pulling, Inc.
Address P.O. Box 1082 Great Bend, Kansas 67530

STATE OF KANSAS, COUNTY OF SEDGWICK, ss.
Wilson Rains (employee of owner) or (owner or operator) of the above-described

well, being first duly sworn on oath, says: That I have knowledge of the facts, statements, and matters herein contained and the log of the above-described well as filed and that the same are true and correct. So help me God.

(Signature) Wilson Rains
1425 Wichita Plaza - Wichita, Kansas
(Address)

SUBSCRIBED AND SWORN TO before me this 2 day of May, 19 69

My commission expires 6-30-71
Sherry Gish Notary Public

15-095-30134-0000
 ROTARY DRILLING LOG

OPERATOR: Rains & Williamson Oil Co.
 #1 LECHNER "A"
 T40' East of C SW NW
 Section 36-30S-7W
 Kingman County, Kansas

CONTRACTOR: Rains & Williamson
 Oil Co.

COMMENCED: 8-26-65
 ROTARY RELEASED: 9-8-65

REMARKS: Set 222' of 8-5/8" surface casing with 165 sacks GL3 cement.

Ran 5 1/2" casing 2' off bottom with 150 sacks salt saturated cement, 2% gel + 1/2# flo seal per sack of cement.

FORMATIONS

Surface Clay & Soil	40'
Sand	105'
Shale	1226'
Anhydrite	1258'
Shale & Lime	1535'
Lime & Shale	2070'
Shale & Lime	2935'
Lime & Shale	3555'
Sand & Shale	3640'
Lime	4384'
Cherty Lime	4440'
Lime & Chert	4535'
Lime	4602'
Lime & Shale	4645'
Lime	4730'
Simpson	4732'
Rotary Total Depth	4732'

RECEIVED
 STATE CORPORATION COMMISSION
 APR 21 1969
 CONSERVATION DIVISION
 Wichita, Kansas

We certify the above log is true and correct to the best of our knowledge and belief.

RAINS & WILLIAMSON OIL CO.

Wilson Rains
 Wilson Rains, Partner

Subscribed and sworn to before me, a Notary Public in and for the State of Kansas, County of Sedgwick, this 13th day of September, 1965.

My Commission Expires:
 January 8, 1968

Shirley Keck
 Shirley Keck, Notary Public