

Give All Information Completely
Make Required Affidavit
Mail or Deliver Report to:
Conservation Division
State Corporation Commission
212 W. Market
Wichita, Kansas

WELL PLUGGING RECORD

Kingman County, Sec 3 Twp. 30 Rge. 8 (E) W (W)

Location as "NE/CNWxSWx" or footage from lines SE SE NE

Lease Owner Pickrell Drilling Co.

Lease Name Bartholf Well No. 1

Office Address 705 Fourth Natl. Bank Bldg. Wichita

Character of Well (completed as Oil, Gas or Dry Hole) Gas

Date well completed Dec. 9, 1955

Application for plugging filed Oct. 30, 1968

Application for plugging approved Nov. 3, 1968


Plugging commenced Nov. 20, 1968

Plugging completed Nov. 22, 1968

Reason for abandonment of well or producing formation Depleted gas well

If a producing well is abandoned, date of last production Jan. 31, 1968

Was permission obtained from the Conservation Division or its agents before plugging was commenced? Yes

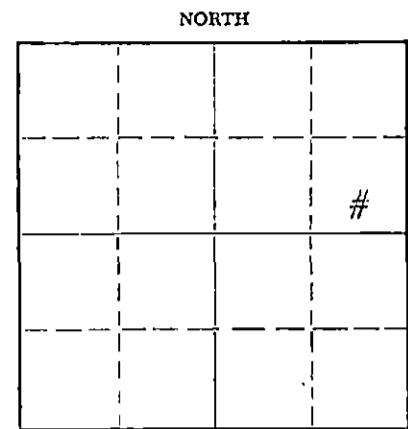

Locate well correctly on above Section Plat

Name of Conservation Agent who supervised plugging of this well Ralph Werran

Producing formation Mississippian Depth to top 4155 Bottom 4436 Total Depth of Well 4732 Feet

Show depth and thickness of all water, oil and gas formations.

OIL, GAS OR WATER RECORDS

CASING RECORD

FORMATION	CONTENT	FROM	TO	SIZE	PUT IN	PULLED OUT
				8 5/8	120'	None
				5 1/2	4716'	3878'

Describe in detail the manner in which the well was plugged, indicating where the mud fluid was placed and the method or methods used in introducing it into the hole. If cement or other plugs were used, state the character of same and depth placed, from _____ feet to _____ feet for each plug set.

Plugged back with sand from 4250' to 4140'. Mixed and dumped 5 sx. of cement from 4140' to 4100'. Pulled casing. Mudded hole to 120'. Set 10' rock bridge from 120' to 110'. Mixed and dumped 35 sx. of cement from 110' to base of the cellar.

RECEIVED
STATE CORPORATION COMMISSION
DEC 12 1968
CONSERVATION DIVISION
Wichita, Kansas
12-12-68

(If additional description is necessary, use BACK of this sheet)

Name of Plugging Contractor Russ Casing Pulling Inc.

Address Box 1082 Great Bend, Ks.

STATE OF Kansas COUNTY OF Sedgwick, ss.

Dale M. Robinson

(employee of owner) (owner or operator) of the above-described

well, being duly sworn on oath, says: That I have knowledge of the facts, statements, and matters herein contained and the log of the above-described well, and that the same are true and correct. So help me God.

(Signature)


Dale M. Robinson

705 4th Nat'l. Bank Bldg., Wichita, Kansas 67202 (Address)

Subscribed and sworn to before me this 11th day of December, 1968

My commission expires May 10, 1970

L. M. Whiting
L. M. Whiting
Notary Public.

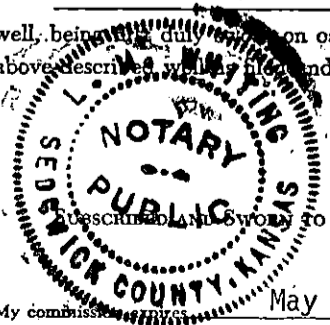

ROTARY DRILLING LOG

COMPANY: Pickrell Drilling Company, Inc.
Wichita, Kansas

Rotary Drilling Commenced 11/12/55

LOCATION: North of #1, 80 05 NE
Sec. 3-30-55, Kingman County, Kansas

Rotary Drilling Completed 12/1/55

CONTRACTOR: PICKRELL DRILLING COMPANY
Wichita, Kansas

CASING RECORD:
120' (3 Jts) of 3 5/8" spiralweld casing cemented
with 125 sack cement circulated
215 Jts of 5 1/2" casing set at 4716' with 150
sack cement.

LOG

(Figures indicate bottom of formation - measurements from top of rotary bushing.)

Red Buck	120	Circ. for samples at 3683
Red bed l. shale	130	1150
shale & shells & salt	1195	1160
lime & shale	1235	1175
lime & shells	1615	1180
lime & shale	1775	1190
lime	1910	1206
shale	2180	1250
shale & lime	2765	1165
lime	1152	1512
Mississippi Lime	1535	1635
Shale	1511	
Flint lime	4730 B.M.	

S.L.R. at 2509 - O.R.
S.L.R. at 3603 - O.R.
S.L.R. at 4206 - O.R.

Slope Test at 2509 - 0°
Slope Test at 3603 - 0°
Slope Test at 4206 - 0°

Hypocrite

RECEIVED
STATE CORPORATION COMMISSION
OCT 3 1 1968
CONSERVATION DIVISION
Wichita, Kansas

The undersigned, G. W. Sebitt, Attorney-in-Fact for PICKRELL DRILLING COMPANY, hereby certifies in behalf of said Company, that the above is a true and correct log of the formation encountered in drilling the above well as reflected by the Daily Drilling Reports.

PICKRELL DRILLING COMPANY
By *G. W. Sebitt*
Attorney-in-Fact

STATE OF KANSAS, }
COUNTY OF SEDGWICK: } ss.

On this 04th day of December, 1955, before me the undersigned, a Notary Public, in and for

the County and State aforesaid, personally appeared G. W. Sebitt, to me known to be the identical person who subscribed the name of PICKRELL DRILLING COMPANY to the foregoing instrument as its Attorney-in-Fact and acknowledged to me that he executed the same as his free and voluntary act and deed, and as the free and voluntary act and deed of such company, for the uses and purposes therein set forth.

Given under my hand and seal of office the day and year last above written.

My commission expires: July 30, 1958

Wesley L. Oster
Notary Public