

STATE OF KANSAS  
STATE CORPORATION COMMISSION

Form CP-4

WELL PLUGGING RECORD

Give All Information Completely  
Make Required Affidavit  
Mail or Deliver Report to:  
Conservation Division  
State Corporation Commission  
212 No. Market  
Wichita, Kansas

Kingman County. Sec. 3 Twp. 30S Rge. 8 (E) W (W)  
Location as "NE/CNW/SW" or footage from lines SE NW SE

Lease Owner Pickrell Drlg. Co.

Lease Name Bertholf "C" Well No. #1

Office Address 705 Fourth National Bank Bldg., Wichita, Ks.

Character of Well (completed as Oil, Gas or Dry Hole) Gas

Date well completed June 29 1956

Application for plugging filed January 9 1970

Application for plugging approved January 13 1970


Plugging commenced January 29 1970

Plugging completed February 2 1970

Reason for abandonment of well or producing formation Mechanical difficulties -  
Drilled replacement well

If a producing well is abandoned, date of last production October 11 1969

Was permission obtained from the Conservation Division or its agents before plugging was commenced? Yes

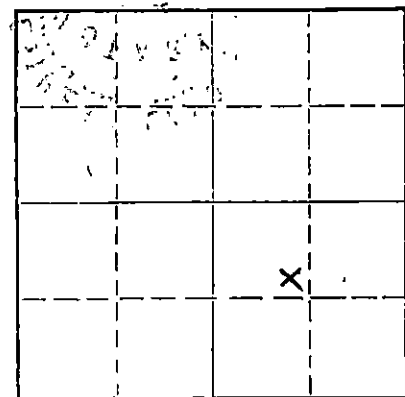

Locate well correctly on above Section Plat

Name of Conservation Agent who supervised plugging of this well Russell Biberstein

Producing formation Mississippian Depth to top 414 Bottom --- Total Depth of Well 4290 Feet

Show depth and thickness of all water, oil and gas formations.

OIL, GAS OR WATER RECORDS

CASING RECORD

FORMATION	CONTENT	FROM	TO	SIZE	PUT IN	PULLED OUT
				8 5/8	257	None
				5 1/2	4245	3505
RECEIVED STATE CORPORATION COMMISSION JUN-25-1970 CONSERVATION DIVISION Wichita, Kansas 6-25-70						

Describe in detail the manner in which the well was plugged, indicating where the mud fluid was placed and the method or methods used in introducing it into the hole. If cement or other plugs were used, state the character of same and depth placed, from \_\_\_\_\_ feet to \_\_\_\_\_ feet for each plug set.

January 29, 1970 Plugged off bottom. Dumped sand to 4100'.  
Mixed and dumped 5 sx of cement to 4060'.

February 2, 1970 Plugged well. Set 10' rock bridge from 250' to 240'. Mixed and dumped 25 sx of cement from 240' to 165'. Mudded casing to 40'. Set 10' rock bridge from 40' to 30'. Mixed and dumped 10 sx of cement from 30' to base of cellar.

(If additional description is necessary, use BACK of this sheet)

Name of Plugging Contractor RUSS CASING PULLING, INC.  
Address P. O. BOX 1082 GREAT BEND, KANSAS 67530

STATE OF Kansas COUNTY OF Sedgwick, ss.  
Dale M. Robinson (employee of owner) or (owner or operator) of the above-described

well, being first duly sworn on oath, says: That I have knowledge of the facts, statements, and matters herein contained and the log of the above-described well as filed and that the same are true and correct. So help me God.

(Signature) Dale M. Robinson  
705 Fourth National Bank Bldg, Wichita, Kansas  
(Address)

SUBSCRIBED AND SWORN to before me this 24th day of June, 1970

Esther Lamone  
Esther Lamone Notary Public.

My Commission expires January 19, 1973



# WELL LOG

15-095-00609-0000

COMPANY **SOHIO PETROLEUM COMPANY**

SEC. 3 T. 30S R. 8W

FARM **Bertholf** NO. 1


LOC. SE NW SE

TOTAL DEPTH **4290'**

COUNTY **Kingman Co., Kansas**

COMM. **June 2, 1956** COMP. **June 16, 1956**

CONTRACTOR **GARVEY DRILLING COMPANY**

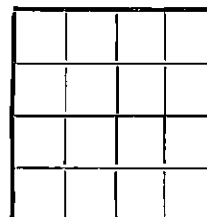

CASING **8-5/8" @ 257' w/250 sacks**  
**4-1/2" @ 4222' w/100 sacks**

ELEVATION **1515 D.F.**

PRODUCTION

FIGURES INDICATE BOTTOM OF FORMATIONS

258	Surface Sand & Clay
1060	Shale
1570	Shale & Lime
2055	Lime
3405	Lime & Shale
3460	K.C. Lime
3857	Lime
4140	Shale & Lime
4162	Chert
4201	Lime & Chert
4290	Lime
4290	T.D.

RECEIVED  
STATE CORPORATION COMMISSION  
JAN 9 1970  
CONSERVATION DIVISION  
Wichita, Kansas

State of KANSAS }  
County of SEDGWICK } ss:

I, Carl Hurty of GARVEY DRILLING COMPANY

upon oath state that the above and foregoing is a true and correct copy of the log of the #1 Bertholf well

*Carl Hurty*

Subscribed and sworn to before me this 28th day of June 19 56

My Commission Expires: July 8, 1958

*D. M. Kennedy*  
NOTARY PUBLIC