


STATE OF KANSAS
STATE CORPORATION COMMISSION

Give All Information Completely
Make Required Affidavit
Mail or Deliver Report to:
Conservation Division
State Corporation Commission
800 Bittling Building
Wichita, Kansas

WELL PLUGGING RECORD

NORTH

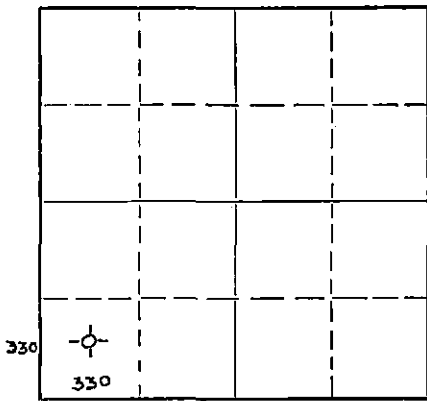

Locate well correctly on above
Section Plat

Barton County. Sec. 3 Twp. 16 S Rge. 11 (E) (W)
Location as "NE/CNW/SW" or footage from lines 330' FSL 330' FWL
Lease Owner Grant Oil Company
Lease Name Alden Well No. 1
Office Address 518 W-K-H Bldg, Wichita 2, Kansas
Character of Well (completed as Oil, Gas or Dry Hole) Dry Hole
Date well completed August 26 19 56
Application for plugging filed September 4 19 56
Application for plugging approved September 5 19 56
Plugging commenced August 13 19 56
Plugging completed August 15 19 56
Reason for abandonment of well or producing formation Dry

If a producing well is abandoned, date of last production Never produced 19
Was permission obtained from the Conservation Division or its agents before plugging was commenced? Yes

Name of Conservation Agent who supervised plugging of this well R. M. Brundage
Producing formation Arbuckle Depth to top 3323 Bottom 3336 Total Depth of Well 3336 Feet
Show depth and thickness of all water, oil and gas formations.

OIL, GAS OR WATER RECORDS				CASING RECORD		
FORMATION	CONTENT	FROM	TO	SIZE	PUT IN	PULLED OUT
Surface	water	0	319	8 5/8	319'	None
Arbuckle	dry	0	3326	5 1/2	3326'	2725'

Describe in detail the manner in which the well was plugged, indicating where the mud fluid was placed and the method or methods used in introducing it into the hole. If cement or other plugs were used, state the character of same and depth placed, from feet to feet for each plug set.

Filled hole with sand to 3310', Dumped 5 sacks cement, mud to 319' Rock Bridge, Dump 20 sacks cement, mud to 35', Rock Bridge, Dump 10 sacks cement to top.

9-29-56

(If additional description is necessary, use BACK of this sheet)
Name of Plugging Contractor Arnett Casing Pulling Co. License # 265
Address Hoisington, Kansas

STATE OF KANSAS, COUNTY OF SEDGWICK, ss.
W. A. Grant (employee of owner) or (owner or operator) of the above-described well, being first duly sworn on oath, says: That I have knowledge of the facts, statements, and matters herein contained and the log of the above-described well as filed and that the same are true and correct. So help me God.

(Signature) W. A. Grant

518 W-K-H Bldg, Wichita 2, Kansas
(Address)

SUBSCRIBED AND SWORN TO before me this 26th day of September 19 56
NOTARY PUBLIC
My Commission Expires March 1, 1960
Katherine Barkley
Notary Public.

PLUGGING
FILE SEC. 3 T 16 R 11 W
BOOK PAGE 96 LINE 7

ALDEN NO. 1

Location:	SW/4 SW/4 SE/4 Sec. 3-16S-11W, Barton County, Kansas	Date Spudded: 8-16-56
Operator:	Grant Oil Company	Rotary Completion: 8-26-56
Contractor:	Walters Drilling Co.	Elevation: 1865 Gr 1867 DF 1870 KB
Surface Casing:	8 5/8" set at 319' with 185 sacks cement and 3 Gal. Chloride	
Oil String:	5 1/2" set at 3326' with 100 sacks cement	

L O G

(Figures indicate bottom of formation)

Surface	0 to 319
Shale and Shells	704
Anhydrite	730
Shale and Shells	1500
Lime and Shale	3097
Lime	3336
Rotary Total Depth	3336

The undersigned, Robert F. Walters, hereby certifies that the above log is a true and correct log of the formations encountered in drilling the above noted well as reflected by the Daily Drilling Reports.

WALTERS DRILLING CO.

By

Robert F. Walters

Subscribed and sworn to before me
this 29th day of August, 1956

Pauline Henderson
Notary Public

My commission expires:
March 10, 1960

