


WELL PLUGGING RECORD

Give All Information Completely
Make Required Affidavit
Mail or Deliver Report to:
Conservation Division
State Corporation Commission
800 Bittling Building
Wichita, Kansas

NORTH

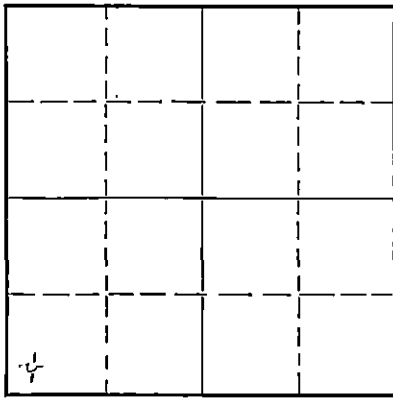

Locate well correctly on above Section Plat

Barton County. Sec. 5 Twp. 16S. Rge. 11 (E) (W)
Location as "NE/CNW $\frac{1}{4}$ SW $\frac{1}{4}$ " or footage from lines SW SW SW
Lease Owner Brunson Drilling Company, Inc.
Lease Name Thill Well No. 1
Office Address 333 First Nat'l Bank Bldg., Wichita, Kansas
Character of Well (completed as Oil, Gas or Dry Hole) Dry
Date well completed March 25, 19 51
Application for plugging filed March 25, 19 51
Application for plugging approved March 25, 19 51
Plugging commenced March 25, 19 51
Plugging completed March 25, 19 51
Reason for abandonment of well or producing formation

If a producing well is abandoned, date of last production 19
Was permission obtained from the Conservation Division or its agents before plugging was commenced? Yes

Name of Conservation Agent who supervised plugging of this well Eldon Petty
Producing formation Depth to top Bottom Total Depth of Well Feet
Show depth and thickness of all water, oil and gas formations.

OIL, GAS OR WATER RECORDS

CASING RECORD

Formation	Content	From	To	Size	Put In	Pulled Out
				8 5/8	299	

Describe in detail the manner in which the well was plugged, indicating where the mud fluid was placed and the method or methods used in introducing it into the hole. If cement or other plugs were used, state the character of same and depth placed, from feet to feet for each plug set.

Plugged back with crushed rock from 3310' to 3300'.
Dumped 5 sax cement at 3300' with dump bailer, top of cement 3265'.
Filled hole with mud to 299', set rock bridge, dumped 10 sax cement for cap.

MAR 21 1951
3-3-51
WICHITA STATE UNIVERSITY

(If additional description is necessary, use BACK of this sheet)

Correspondence regarding this well should be addressed to Brunson Drilling Company, Inc.
Address Above

STATE OF Kansas, COUNTY OF Sedgwick, ss.

Ralph B. McLaughlin (employee of owner) or (owner or operator) of the above-described well, being first duly sworn on oath, says: That I have knowledge of the facts, statements, and matters herein contained and the log of the above-described well as filed and that the same are true and correct. So help me God. Brunson Drilling Company, Inc.

(Signature) Ralph B. McLaughlin
333 First Nat'l. Bank Bldg., Wichita, Kan.
(Address)

SUBSCRIBED AND SWORN to before me this 30th day of March, 19 51

Edwin C. Combs
Notary Public.

My commission expires September 23, 1953

PLUGGING
FILE SEC 5 T 16 R 11 W
BOOK PAGE 69 LINE 45

15-009-00378-00W

Brunson Drilling Company, Inc. et al
Wichita, Kansas

Well: Thill #1

SW SW SW Sec. 5-16S-11W
Barton County, Kansas

Commenced R.D.: 3/14/51
Completed R.D.: 3/25/51
Total Depth : 3310'

Elevation : 1802 D.F.
Initial Prod. : Dry
Contractor : Brunson Drlg. Co., Inc.

Casing: 299' 8 5/8" OD 8 rd thd 24#

STRATA	DEPTH
Surface Soil & Clay	20
Sand	35
Shale	130
Sand & Shale	155
Shale & Sand	230
Clay	290
Shale	305
Sand	340
Pyrite & Sand	345
Pyrite	351
Sand	385
Shale & Shells	450
Redbeds	672
Anhydrite	705
Shale & Shells	1120
Salt	1280
Shale & Shells	1335
Broken Lime	1580
Lime & Shale	1805
Shale & Lime	2120
Shale	2625
Shale & Lime	2738
Lime & Shale	2885
Lime, Sand & Shale	2967
Lime & Shale	3073
Lime, Shale & Chirt	3119
Lime	3159
Lime & Shale	3307
Lime, Chirt & Shale	3310
Total Depth	3310

TOPS	
Heebner	2864
Toronto	2881
Douglas Section	2891
Brown Lime	2954
Lansing	2972
Conglomerate	3269

REC'D
STATE DEPARTMENT
MAR 31 1951
CONVENTION DIVISION
Wichita, Kansas

I hereby certify that the above is a true and correct log of said well as reflected by the daily drilling reports.

BRUNSON DRILLING COMPANY, INC.
By

Ralph B. M. Laughlin
William S. Brunson Sec.-Treas.

Signed and sworn to in my presence this 30th day of March, 1951, by William S. Brunson, Sec.-Treas. of the Brunson Drilling Company, Inc., a corporation in the State of Kansas.

PLUGGING
FILE SEC 5-16-R-11W
BOOK PAGE 69 LINE 45

Edwina C. Combs
Notary Public

My commission expires September 23, 1953.