


STATE OF KANSAS
STATE CORPORATION COMMISSION

15-009-06283-0000

Give All Information Completely
Make Required Affidavit
Mail or Deliver Report to:
Conservation Division
State Corporation Commission
211 No. Broadway
Wichita, Kansas

WELL PLUGGING RECORD

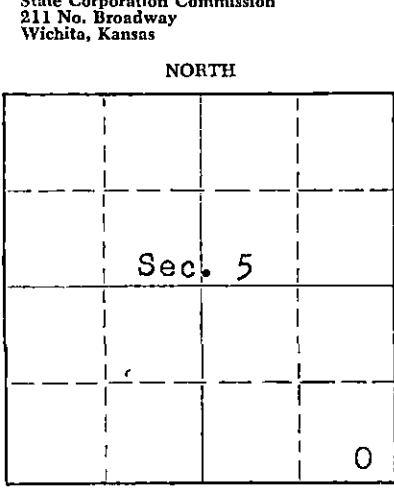

Locate well correctly on above Section Plat

BARTON County. Sec. 5 Twp. 16 Rge. 11 (~~E~~) W (W)
Location as "NE/CNW/SW" or footage from lines SE SE SE
Lease Owner PETROLEUM, INC.
Lease Name THILL Well No. 1
Office Address ROUTE #2, GREAT BEND, KANSAS
Character of Well (completed as Oil, Gas or Dry Hole) DRY HOLE
Date well completed March 3; 19 58
Application for plugging filed March 6; 19 58
Application for plugging approved March 7; 19 58
Plugging commenced March 2; 19 58
Plugging completed March 3, 19 58
Reason for abandonment of well or producing formation No Produccible Zones
If a producing well is abandoned, date of last production None 19
Was permission obtained from the Conservation Division or its agents before plugging was commenced? Yes

Name of Conservation Agent who supervised plugging of this well Don Truan, Russell, Kansas
Producing formation ----- Depth to top ----- Bottom ----- Total Depth of Well 3305 Feet
Show depth and thickness of all water, oil and gas formations.

OIL, GAS OR WATER RECORDS

CASING RECORD

FORMATION	CONTENT	FROM	TO	SIZE	PUT IN	PULLED OUT
				8-5/8"	360'	None

Describe in detail the manner in which the well was plugged, indicating where the mud fluid was placed and the method or methods used in introducing it into the hole. If cement or other plugs were used, state the character of same and depth placed, from feet to feet for each plug set.

Mud up with heavy mud to 300' pushed down 1/2 sack hulls to 300' followed by wooden plug. Placed 15 sacks cement through drill pipe on to plug. Mud up to 40' and placed 1/2 sack hulls at 40' followed by wooden plug and 10 sacks cement to base of well cellar.

3-17-58

(If additional description is necessary, use BACK of this sheet)
Name of Plugging Contractor GARVEY DRILLING COMPANY
Address ROUTE 2, GREAT BEND, KANSAS

STATE OF KANSAS, COUNTY OF BARTON, ss.
Don Searle (employee of owner) or (~~MINOR INTEREST~~) of the above-described well, being first duly sworn on oath, says: That I have knowledge of the facts, statements, and matters herein contained and the log of the above-described well as filed and that the same are true and correct. So help me God.

(Signature) Don Searle
Route 2, Great Bend, Kansas
(Address)

SUBSCRIBED AND SWORN TO before me this 13th day of March, 19 58
Ed. J. Brown
Notary Public.

My commission expires July 11, 1960

PLUGGING
SEC 5 T 16 R 11
BOOK PAGE 87 LINE 17

WELL LOG

15009-06283-0000

COMPANY PETROLEUM, INCORPORATED

SEC. 5 T. 16S R. 11W

FARM THILL NO. 1


LOC. SE, SE, SE

TOTAL DEPTH 3305'

COUNTY BARTON CO., KANSAS

COMM. February 24, 1958 COMP. March 5, 1958

CONTRACTOR GARVEY DRILLING COMPANY

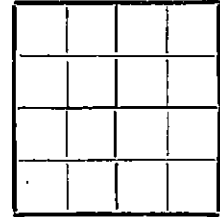

CASING 8 5/8" @ 360' W/200 sax.

ELEVATION 1792' DF

PRODUCTION D & A

FIGURES INDICATE BOTTOM OF FORMATIONS

45	Surface soil & sand
100	Sand
550	Shale & shells
655	Red bed
685	Anhydrite
1410	Shale & shells
1835	Lime & shale
2245	Shale & shells
2940	Shale & lime
3028	Shale
3046	Lime & shale
3270	Lime
3305	Shale & chert
3305	T. D.

RECORDED
STATE OF KANSAS

MAR 17 1958

CONSERVATION DIVISION
Wichita, Kansas

LOGGING
FILE SEC. 5 T. 16S R. 11W
BOOK PAGE 87 LINE 17

State of KANSAS }
County of BARTON } ss:

I, VERNE A. MORRIS of GARVEY DRILLING COMPANY

upon oath state that the above and foregoing is a true and correct copy of the log of the #1 THILL well

Subscribed and sworn to before me this 12th day of March 19 58

My Commission Expires: July 11, 1960

Verne A. Morris
John J. Brown
NOTARY PUBLIC