

Give All Information Completely
Make Required Affidavit
Mail or Deliver Report to:
Conservation Division
State Corporation Commission
800 Bittling Building
Wichita, Kansas

WELL PLUGGING RECORD
OR
FORMATION PLUGGING RECORD

15009-06469-000

Strike out upper line when reporting plugging of formations.

NORTH

		o	

Locate well correctly on above Section Plat

Barton County, Sec. 5 Twp. 16 Rge. (E) 11 (W)
Location as "NE $\frac{1}{4}$ NW $\frac{1}{4}$ SW $\frac{1}{4}$ " or footage from lines 430' from N Line-330' from
Lease Owner: Sohio Petroleum Company W. Line of NE $\frac{1}{4}$
Lease Name: Davidson Well No. 1
Office Address: Box 609, Russell, Kansas
Character of Well (completed as Oil, Gas or Dry Hole) Dry Hole
Date well completed: 6/24/44
Application for plugging filed: 6/24/44 telephone 6/30/44 written
Application for plugging approved: 6/24/44 " 6/30/44 "
Plugging commenced: 6/24/44
Plugging completed: 6/25/44
Reason for abandonment of well or producing formation: Dry hole

If a producing well is abandoned, date of last production 19

Was permission obtained from the Conservation Division or its agents before plugging was commenced? Yes, from Eldon Petty of Great Bend, Kansas

Name of Conservation Agent who supervised plugging of this well: Eldon Petty, Great Bend, Kansas

Producing formation: Depth to top: Bottom: Total Depth of Well 3284 Feet

Show depth and thickness of all water, oil and gas formations.



OIL, GAS OR WATER RECORDS

CASING RECORD

Formation	Content	From	To	Size	Put In	Pulled Out
No oil or gas shows from top of hole to bottom.				8 5/8" O.D.	584'	None

Describe in detail the manner in which the well was plugged, indicating where the mud fluid was placed and the method or methods used in introducing it into the hole. If cement or other plugs were used, state the character of same and depth placed, from feet to feet for each plug set.

3284' to 600' mud
600' to 550' Cement (15 sacks)
550' to 30' Mud & bridge
30' to 5' Cement (10 sacks)
Clay to surface

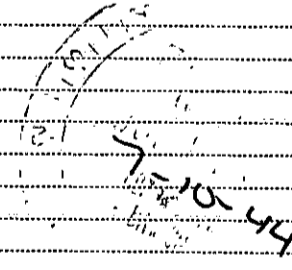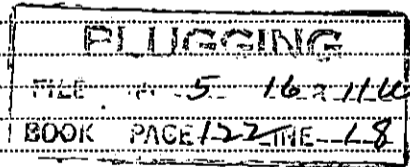

(If additional description is necessary, use BACK of this sheet)

Correspondence regarding this well should be addressed to: Sohio Petroleum Company
Address: Box 609, Russell, Kansas

STATE OF Kansas, COUNTY OF Russell, ss.
P. C. Musgrove (employee of owner) or (owner) of the above-described well,
being first duly sworn on oath, says: That I have knowledge of the facts, statements, and matters herein contained and the log of the above-described well as filed and that the same are true and correct. So help me God.

(Signature) P.C. Musgrove
Box 609, Russell, Ks.
(Address)

SUBSCRIBED AND SWORN to before me this 6th day of July, 1944.

Bernie J. Smith
Notary Public.

My commission expires May 8, 1948.



State: _____

CONTRACTOR'S VERIFIED LOG

Operator Schlo Petroleum Company Farm Name Davidson Well No. I
 Location NW/4 NW/4 NE/4 of Sec. 8-100-11W
 Pool Name Kraft-Prusa area County Barton State Kansas
 Commencement Date 6-8-44 Completion Date 6-25-44

LOG OF WELL

Depth		Formation	Deviation from Vertical (Degrees)	Remarks
From	To			
0	80	Shale-Lime		
80	380	Shale-Lime-Shells		
380	605	Shale-Sand-Red Bed	1/2°	
605	715	Shale-Red Bed-Shells		
715	1470	Shale-Shells	1/2°	
1470	1794	Shale-Shells-Lime	1/2°	
1794	2075	Shale-Red Bed-Broken Lime	1/4°	
2075	2354	Shale-Shells-Lime		
2354	2600	Shale-Shells	0°	
2600	2782	Shale-Broken Lime		
2782	2911	Shale-Lime		
2911	3018	Lime	0°	EG-Lensing Top 2929'
3018	3106	Lime		
3106	3220	Shale-Broken Lime		
3220	3394	Shale-Lime		Completorate T. 3240' Arbuckle Top 3267'

PLUGGING
 FILE 5 169-11W
 BOOK CASE 122 LINE 18-

STATE OF KANSAS
 COMMISSIONER OF GEOL. & MIN.
 JUL 1 1944
 DIVISION OF OIL & GAS

