


WELL PLUGGING RECORD

Give All Information Completely
Make Required Affidavit
Mail or Deliver Report to:
Conservation Division
State Corporation Commission
212 North Market, Insurance Bldg.
Wichita, Kansas

Finney County, Sec. 22 Twp. 24S Rge. 32W (E) (W)

Location as "NE/CNW%SW%" or footage from lines NW NE
Lease Owner AIKMAN BROS. CORPORATION
Lease Name Rameriz Well No. 1
Office Address 1008 Barfield Bldg., Amarillo, Texas
Character of Well (completed as Oil, Gas or Dry Hole) Dry Hole
Date well completed January 18, 1965 19
Application for plugging filed January 20, 1965 19
Application for plugging approved January 20, 1965 19
Plugging commenced January 17, 1965 19
Plugging completed January 18, 1965 19
Reason for abandonment of well or producing formation _____

NORTH

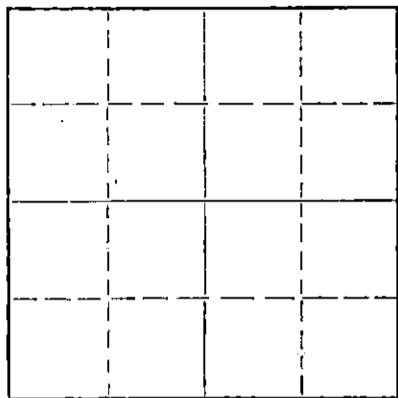

Locate well correctly on above
Section Plat

If a producing well is abandoned, date of last production _____ 19____
Was permission obtained from the Conservation Division or its agents before plugging was commenced? YES

Name of Conservation Agent who supervised plugging of this well Hugh Scott
Producing formation _____ Depth to top. _____ Bottom _____ Total Depth of Well 4920 Feet
Show depth and thickness of all water, oil and gas formations.

OIL, GAS OR WATER RECORDS

CASING RECORD

FORMATION	CONTENT	FROM	TO	SIZE	PUT IN	PULLED OUT

Describe in detail the manner in which the well was plugged, indicating where the mud fluid was placed and the method or methods used in introducing it into the hole. If cement or other plugs were used, state the character of same and depth placed, from _____ feet to _____ feet for each plug set.

Plugged at 2500 ft. w/75 sx cmt
Plugged at 525 ft. w/35 sx cmt
Plugged at 45 ft. w/15 sx cmt

RECEIVED
STATE CORPORATION COMMISSION

JAN 25 1965

1-25-65
CONSERVATION DIVISION
Wichita, Kansas

(If additional description is necessary, use BACK of this sheet)

Name of Plugging Contractor _____
Address _____

STATE OF TEXAS COUNTY OF POTTER, ss.
Dorothy Lindsey (employee of owner) or owner of the above-described well, being first duly sworn on oath, says: That I have knowledge of the facts, statements, and matters herein contained and the log of the above-described well as filed and that the same are true and correct. So help me God.

(Signature) Dorothy Lindsey
Aikman Bros. Corporation
1008 Barfield Bldg.
Amarillo, Texas (Address)

SUBSCRIBED AND SWORN TO before me this 20 day of January, 19 65

My commission expires June 1, 1965 [Signature] Notary Public.

D R I L L E R S L O G

#1 Ramirez

CASING RECORD: 496.71' of new 8-5/8" surface casing.	COMPANY: Aikman Bros. Corporation	DESCRIPTION: NW NE Section 22-24-32W Finney County, Kansas
TOTAL DEPTH: 4920'	CONTRACTOR: Strata Drilling, Inc.	ELEVATION: 2813' GL
	COMMENCED: January 2, 1965	
	COMPLETED: January 18, 1965	

D. & A.

<u>FORMATION</u>	<u>FROM</u>	<u>TO</u>	<u>REMARKS</u>	
Shale	0	70	Ran 496.71' of new 8-5/8" surface casing; set and cemented at 504' with 500 sacks of common cement, 2% gel and 3% calcium chloride. Cement circulated. Plug down at 7:25 A. M. January 3, 1965.	
Sand & Shale	70	210		
Clay & Shale	210	504		
Sand & Shale	504	850		
Shale & Red Bed	850	1309		
Anhydrite	1309	1352		
Red Bed	1352	1430		
Sand	1430	1500		
Shale w/Anhydrite streaks	1500	2030		
Shale & Shells	2030	2400		
Shale & Lime	2400	3015		
Lime	3015	3110		
Lime	3110	3187		
Lime & Shale	3187	3905		
Lime & Chalk	3905	3950		
Lime	3950	4753		Ran two drill stem tests.
Shale & Sand	4753	4760		Ran Welex Logs.
Mississippi Lime	4760	4770		
Lime	4770	4920		

Total Depth 4920'

D. & A.

Hole plugged as follows: Plugged at 2500' with 75 sacks of cement, plugged at 525' with 35 sacks of cement, plugged at 45' with 15 sacks of cement. Plug down at 12:15 A. M. January 18, 1965.

STATE OF KANSAS)
) ss.
COUNTY OF BARTON)

I certify that this is a true and correct copy of the above log to the best of my knowledge.

STRATA DRILLING, INC.

Charles W. Steincamp
Charles W. Steincamp, President

Subscribed and sworn to before me this 19th of January, 1965.

Elaine H. Taylor
Elaine H. Taylor, Notary Public

My Commission Expires:

December 14, 1965