


STATE OF KANSAS
STATE CORPORATION COMMISSION

Give All Information Completely
Make Required Affidavit
Mail or Deliver Report to:
Conservation Division
State Corporation Commission
P. O. Box 17027
Wichita, Kansas 67217
NORTH

WELL PLUGGING RECORD

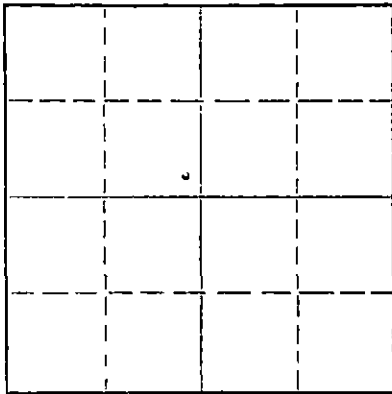

Locate well correctly on above
Section Plat

Finey County. Sec. 11 Twp. 24 Rge. 33 (E) (W)
Location as "NE/CNW/SW" or footage from lines SE SE SE NW
Lease Owner Doug Marden
Lease Name Pete Ma Mai (owner) Well No. 1
Office Address Box 1313 Liberal, Kansas 67901
Character of Well (completed as Oil, Gas or Dry Hole) Gas
Date well completed _____ 19____
Application for plugging filed _____ 19____
Application for plugging approved _____ 19____
Plugging commenced 1-30-74 19____
Plugging completed 1-30 19 74
Reason for abandonment of well or producing formation _____

If a producing well is abandoned, date of last production _____ 19____
Was permission obtained from the Conservation Division or its agents before plugging was commenced? _____

Name of Conservation Agent who supervised plugging of this well Ed Eves
Producing formation _____ Depth to top _____ Bottom _____ Total Depth of Well 2620 Feet
Show depth and thickness of all water, oil and gas formations.

OIL, GAS OR WATER RECORDS

CASING RECORD

FORMATION	CONTENT	FROM	TO	SIZE	PUT IN	PULLED OUT
				7"	2602	None
				10 3/4"	330	None

Describe in detail the manner in which the well was plugged, indicating where the mud fluid was placed and the method or methods used in introducing it into the hole. If cement or other plugs were used, state the character of same and depth placed, from _____ feet to _____ feet for each plug set.

Pump 25 sks. of cement @ 2500
Pump 25 sks. of cement @ 700 to 600
Put 15 sks. of cement @ 75 to 0
18 ft. of open hole

RECEIVED
STATE CORPORATION COMMISSION
FEB 8 1974
CONSERVATION DIVISION
Wichita, Kansas

(If additional description is necessary, use BACK of this sheet)
Name of Plugging Contractor Sargents Casing Pulling Service Kansas No. 511
Address Box 506 Liberal, Kansas 67901

STATE OF KANSAS, COUNTY OF SEWARD, ss.
Douglas W. Marden (employee of owner) or (owner or operator) of the above-described well, being first duly sworn on oath, says: That I have knowledge of the facts, statements, and matters herein contained and the log of the above-described well as filed and that the same are true and correct. So help me God.

(Signature) Douglas W. Marden
Box 1313, Liberal, Kansas 67901
(Address)

SUBSCRIBED AND SWORN TO before me this 6th day of February, 1974

Madonna M. Ishmael
Notary Public.

My commission expires _____

MADONNA M. ISHMAEL
NOTARY PUBLIC
SEWARD CO., KANSAS
MY COMM. EXPIRES MAY 31, 1976

WELL LOG BUREAU-- KANSAS GEOLOGICAL SOCIETY
503 East Murdock, Wichita, Kansas

COPY

Company CHAMPLIN REFINING COMPANY
Farm- Poto Mai No. 1

SEC. 14 7. 24 R. 33W
SE SE SE NW
2540' fr WL & 2540' fr NL NW/4

Total Depth. 2620

Comm. 6-12-53

Start of Test.


Contractor.

Issued. 10-24-53

Comp. 6-19-53

County Finney

KANSAS

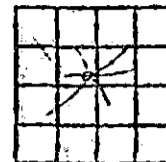

Elevation. 2856 K.B.

Production. 528,000 Gas

Figures Indicate Bottom of Formations.

sand	300
shale	324
shale, shells	850
shale, shells, redbed	1195
sand, anhy., salt	1625
shale, shells, salt	1900
shale, anhy.	2040
shale, lime	2620
Total Depth	

Tops:

Herington	2494
Krider	2520
Winfield	2576

Perf. 2576 - 2613

RECEIVED
STATE CORPORATION COMMISSION
NOV 29 1973
CONSERVATION DIVISION
Wichita, Kansas