


WELL PLUGGING RECORD

Give All Information Completely
Make Required Affidavit
Mail or Deliver Report to:
Conservation Division
State Corporation Commission
211 No. Broadway
Wichita, Kansas

Kingman County. Sec. 24 Twp. 30S Rge. 7 (W) (W)
Location as "NE/CNW&SW" or footage from lines NE NW SE
Lease Owner Clinton Oil Company
Lease Name Shriver Well No. 1
Office Address 6810 W. Highway 54, Wichita, Kansas 67209
Character of Well (completed as Oil, Gas or Dry Hole) Dry Hole
Date well completed December 18 19 66
Application for plugging filed December 20 19 66
Application for plugging approved December 19 19 66
Plugging commenced December 19 19 66
Plugging completed December 19 19 66
Reason for abandonment of well or producing formation Dry

NORTH

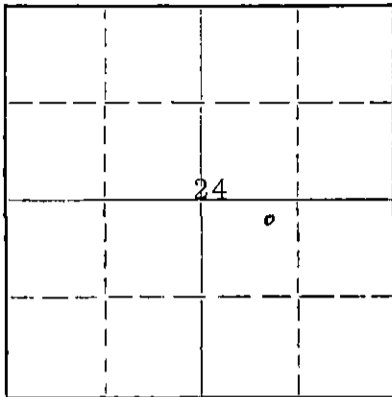

Locate well correctly on above
Section Plat

If a producing well is abandoned, date of last production _____ 19 ____
Was permission obtained from the Conservation Division or its agents before plugging was commenced? Yes

Name of Conservation Agent who supervised plugging of this well Archie Elving, Pratt, Kansas
Producing formation _____ Depth to top _____ Bottom _____ Total Depth of Well 4274 Feet
Show depth and thickness of all water, oil and gas formations.

OIL, GAS OR WATER RECORDS

CASING RECORD

FORMATION	CONTENT	FROM	TO	SIZE	PUT IN	PULLED OUT
				8 5/8"	280'	None

Describe in detail the manner in which the well was plugged, indicating where the mud fluid was placed and the method or methods used in introducing it into the hole. If cement or other plugs were used, state the character of same and depth placed, from _____ feet to _____ feet for each plug set.

Plugged with heavy mud to 275', Plug, 1/2 sx. hulls,
25 sx cement. Heavy mud to 40', Plug, 1/2 sx hulls,
10 sx. cement. Plugged mouse & rat holes with 2 sx cement each.
Job Complete 10:00 A.M. December 19, 1966

12-21-66
RECEIVED
STATE CORPORATION COMMISSION
DEC 21 1966
CONSERVATION DIVISION
Wichita, Kansas

(If additional description is necessary, use BACK of this sheet)

Name of Plugging Contractor Garvey Drilling Company
Address Rt. 2, Great Bend, Kansas

STATE OF KANSAS, COUNTY OF SEDGWICK, ss.
Earl O. Brandt (employee of owner) or (owner or operator) of the above-described well, being first duly sworn on oath, says: That I have knowledge of the facts, statements, and matters herein contained and the log of the above-described well as filed and that the same are true and correct. So help me God.

(Signature) Earl O. Brandt
Earl O. Brandt
6810 W. Highway 54, Wichita, Kansas
(Address)

SUBSCRIBED AND SWORN to before me this 20th day of December, 19 66

My commission expires January 24, 1968


Allen T. Denton
Allen T. Denton
Notary Public.

WELL LOG

COMPANY Clinton Oil Company
 FARM Shriver NO. 1-V
 TOTAL DEPTH 4270'
 COMM. 12-9-66 COMP. 12-19-66
 CONTRACTOR Garvey Drilling Company

BEG. 24 T. 30S R. 7W
 LOC. NE NW SE

COUNTY Kingman

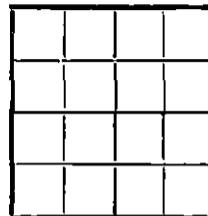

CASING 8 5/8" @ 280' w/200 sx

ELEVATION 1518' GL

PRODUCTION D & A

FIGURES INDICATE BOTTOM OF FORMATIONS

- 110' Red Bed
- 280' Shale and Red Bed
- 680' Red Bed and Shale
- 1175' Shale and Shells
- 1420' Shale and Lime Streaks
- 1500' Sand and Shale
- 1777' Lime
- 1990' Shale and Lime
- 2295' Lime and Shale
- 2490' Shale with Lime Streaks
- 3225' Shale and Lime
- 3320' Lime and Shale
- 3508' Shale and Lime
- 3690' Lime and Shale
- 4196' Lime
- 4241' Lime, Shale and Chert
- 4270' Lime and Chert
- 4270' RTD

RECEIVED
 STATE CORPORATION COMMISSION

DEC 29 1966

CONSERVATION DIVISION
 Wichita, Kansas

State of Kansas
 County of Barton } ss

I, Sam H. Stephens of Garvey Drilling Company

upon oath state the above and foregoing is a true and correct copy of the log of the Shriver No. 1-V well.

Sam H. Stephens

Subscribed and sworn to before me this 21st day of December 19 66

My Commission Expires: November 5th, 1969

Richard D. Doy
 NOTARY PUBLIC