


STATE OF KANSAS
STATE CORPORATION COMMISSION

Give All Information Completely
Make Required Affidavit
Mail or Deliver Report to:
Conservation Division
State Corporation Commission
211 No. Broadway
Wichita, Kansas

15-095-00147-0000
WELL PLUGGING RECORD

NORTH

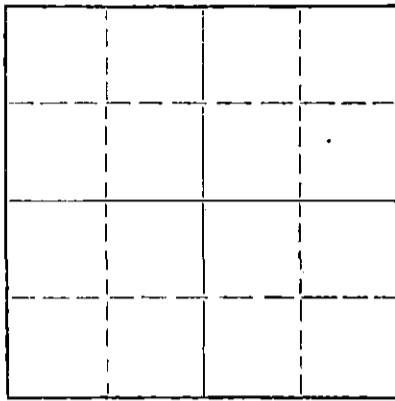

Locate well correctly on above
Section Plat

Kingman County. Sec. 31 Twp. 30S Rge. 7W (W)
Location as "NE/CNW/SW" or footage from lines NW/NW/SW
Lease Owner Anschutz Drilling Co., Inc.
Lease Name VALDOIS Well No. 1
Office Address 709 Union National Bank Bldg., Wichita, Kansas
Character of Well (completed as Oil, Gas or Dry Hole) Dry Hole
Date well completed 10-2-56 19
Application for plugging filed 10-2-56 19
Application for plugging approved 10-4-56 19
Plugging commenced 10-2-56 19
Plugging completed 10-2-56 19
Reason for abandonment of well or producing formation Dry Hole

If a producing well is abandoned, date of last production 19
Was permission obtained from the Conservation Division or its agents before plugging was commenced? Yes

Name of Conservation Agent who supervised plugging of this well Mr. M. A. Rives, Box 8, Pratt, Kansas.
Producing formation _____ Depth to top _____ Bottom _____ Total Depth of Well 4469' Feet
Show depth and thickness of all water, oil and gas formations.

OIL, GAS OR WATER RECORDS

CASING RECORD

FORMATION	CONTENT	FROM	TO	SIZE	PUT IN	PULLED OUT
Sand, Gravel, Clay & Red Bed		0'	205'	8-5/8"	205'	None

Describe in detail the manner in which the well was plugged, indicating where the mud fluid was placed and the method or methods used in introducing it into the hole. If cement or other plugs were used, state the character of same and depth placed, from _____ feet to _____ feet for each plug set.

Plugged hole, Mud to 200', 1/4 sack hulls & plug @ 200', 20 sacks cement, Mud to 35', 1/4 sack hulls & plug tied W/wire @ 35', 10 sacks cement to top of surface pipe.

(If additional description is necessary, use BACK of this sheet)

Name of Plugging Contractor Graham-Michaelis Drilling Co.
Address 1005 East Second St., Wichita, Kansas.

STATE OF KANSAS, COUNTY OF SEDGWICK, ss.
W. A. Michaelis, Jr. (employee of owner) or (owner or operator) of the above-described well, being first duly sworn on oath, says: That I have knowledge of the facts, statements, and matters herein contained and the log of the above-described well as filed and that the same are true and correct. So help me God. Graham-Michaelis Drilling Co.
(Signature) W. A. Michaelis, Jr., Managing Partner.
1005 East Second St., Wichita, Kansas.
(Address)

SUBSCRIBED AND SWORN to before me this 9th day of October, 1956.

My commission expires 11/7/57.

Mary L. Basner
Notary Public.
STATE CORPORATION COMMISSION

PLUGGING
FILE SEC. 31 T. 30 R. 7W
BOOK PAGE 104 LINE 33

OCT 10 1956 10-10-56
CONSERVATION DIVISION
Wichita, Kansas

WELLS #1

Well Record

Location: NW NW SW Section 31-30S-7W
Kingman County, Kansas
Commenced: September 20, 1956
Completed: October 3, 1956
(rotary)

Operator: Anschutz Drilling Co., Inc.
709 Union National Bank Building
Wichita, Kansas

Contractor: Graham-Michaelis Drilling Co.
1005 East Second Street
Wichita 1, Kansas

Casing Records: 8-5/8" @ 205' w/150 sacks cement

	<u>LOG</u>
Sand & Gravel	30
Surface Clay	35
Gravel	110
Red Bed	205
Red Bed & Shale	700
Shale & Shells	1115
Shale, Anhydrite Streaks	1360
Shale & Lime	2150
Shale	2608
Lime & Shale	3168
Shale, Lime & Sand	3354
Lime & Shale	3515
Lime	3787
Lime & Shale	3868
Lime	4340
Lime & Shale	4376
Miss. Chert, & Lime	4397
Lime & Chert	4429
Lime	4469, RTD.

STATE OF KANSAS)
) ss.
COUNTY OF SEDGWICK)

The undersigned, GRAHAM-MICHAELIS DRILLING COMPANY, hereby certifies that the above log is a true and correct log of the formations encountered in drilling the above well as reflected by the Daily Drilling Report.

GRAHAM-MICHAELIS DRILLING COMPANY

By John L. James
John L. James
Geologist.

Subscribed and sworn to before me
this 9th day of October, 1956.

Mary L. Barnes
My commission expires: 11/7/57.

REC
STATE CORP

OCT
CONSE

PLUGGING
FILE SEC 31 T 30 R 7W
BOOK PAGE 104 LINE 33