


WELL LOG BUREAU—KANSAS GEOLOGICAL SOCIETY 15-069-00016-0000  
 412 Union National Bk. Bldg., Wichita, Kansas

Company- TEXAS COMPANY  
 Farm- A. L. Seal No. 1

SEC. 9 T. 24 R. 27 W  
 NWc NW  
 330' fNL 330' fWL NW $\frac{1}{4}$

Total Depth. 5550'  
 Comm. 3-9-45 Comp. 4-5-45  
 Shot or Treated.  
 Contractor. Kiowa Drlg. Co.  
 Issued. 5-26-45

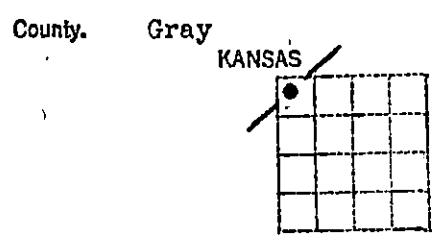

CASING:  
 13 3/8" 201# Cem.  
 8 5/8" 2060# Cem.

Elevation. \_\_\_\_\_  
 Production. Dry

Figures Indicate Bottom of Formations.


surface-shale-shells	187
shale & shells	400
water & sand	460
shale & shells	750
shale & water sand	975
shale & shells	1190
red bed & shells	1215
red bed & anhydrite	1770
anhydrite	1825
lime	1850
shale & shells	2205
lime & brkn anhydrite	2305
shale & shells	2450
anhydrite & red bed	2585
shale & shells	2610
lime	2690
shale & shells	2755
lime & shale	3100
lime	3580
lime & shale	3610
lime	3775
lime brkn & shale	3810
lime	3858
lime & shale	3880
lime	4010
shale	4015
lime	4145
lime & chert	4320
lime & brkn dolomite	4415
lime	4580
lime & chert	4625
lime	4640
lime & chert	4680
lime	4690
lime	4700
shale	4703
lime & shale	4740
lime	4765
lime & chert	4780
chert	4783
chert & lime	4835
lime	5100
chert	5140
lime & chert	5175
lime	5194
lime	5250
sand	5272
lime	5400
lime & shale	5420
lime & chert	5451
lime	5510
lime & chert	5546
lime	5550
Total Depth.	

Tops: (continued)

Viola	5220
Simpson	5391
Arbuckle	5402
Core #1 4690-4703 - 10' Rec.	
shale & lime	
Core #2 5194-5209 - 3 $\frac{1}{2}$ ' Rec.	
lime	
Core #3 5300-5315 - 4 $\frac{1}{2}$ ' Rec.	
dolomite	
Core #4 5393-5406 - 5' Rec.	
dolomite, no show.	
Core #5 5451-5461 - 5' Rec.	
dolomite porous	

Tops:

Stone Corell	1760
Lansing	4008
Conglomerate	4747
Miss.	4764
Kinderhook	5134

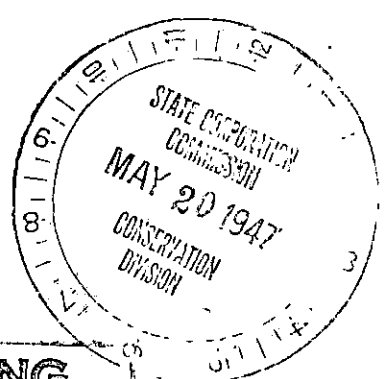

**PLUGGING**  
 FILE SEC 9 T 24 R 27 W  
 BOOK PAGE 12 LINE 26