

15-039-19017-00-01

UPDATE REPORT

Date: December 29, 2015

Operator: Bach Oil Production

License: 31569

Location: SW-NE-NE/4 Sec. 11-1-27W

Lease: Sater # 4 (Warner Unit # 104)

County: Decatur

Findings:

- On December 29, 2015 a file review was conducted on the Sater # 4 located SW-NE-NE/4 of section 11-1-27W. The well appeared on the RBDMS well status list as 'DR'.
- The Sater # 4 was spudded on September 22, 1956. 8 5/8 surface casing was set to 320 ft. 5 1/2 production casing was set to 3467'. TD was reported to be 3468'. The assigned API # was 15-039-00524.
- The Sater # 4 was included in a water-flood project and was renamed 'Warner Unit # 104' by Cities Service Oil Company. The well was converted to an EOR well, becoming the 'Warner Unit # 104W'. The docket # was E-12, 401 0002.
- Energy Search Operating Company purchased the Warner Unit and abandoned the Warner Unit # 104W. The well set idle and was TA'd on February 1, 2010. The TA # was 4-004,415. The TA was denied after several years causing the well to be plugged on March 12, 2014. The well plugging was witness by KCC staff. The API # was 15-039-19,017-0001. The pipe settings, TD and perforations closely matched the information reported on the scout card (Sater # 4). The API #'s 15-039-00524 & 15-039-19,017-0001 identify the same well.


Darrel Dipman ECRS
(agent)

Darrel Dipman
(signature)

cc: file

Section 11-01-27W, Decatur County, Kansas

N

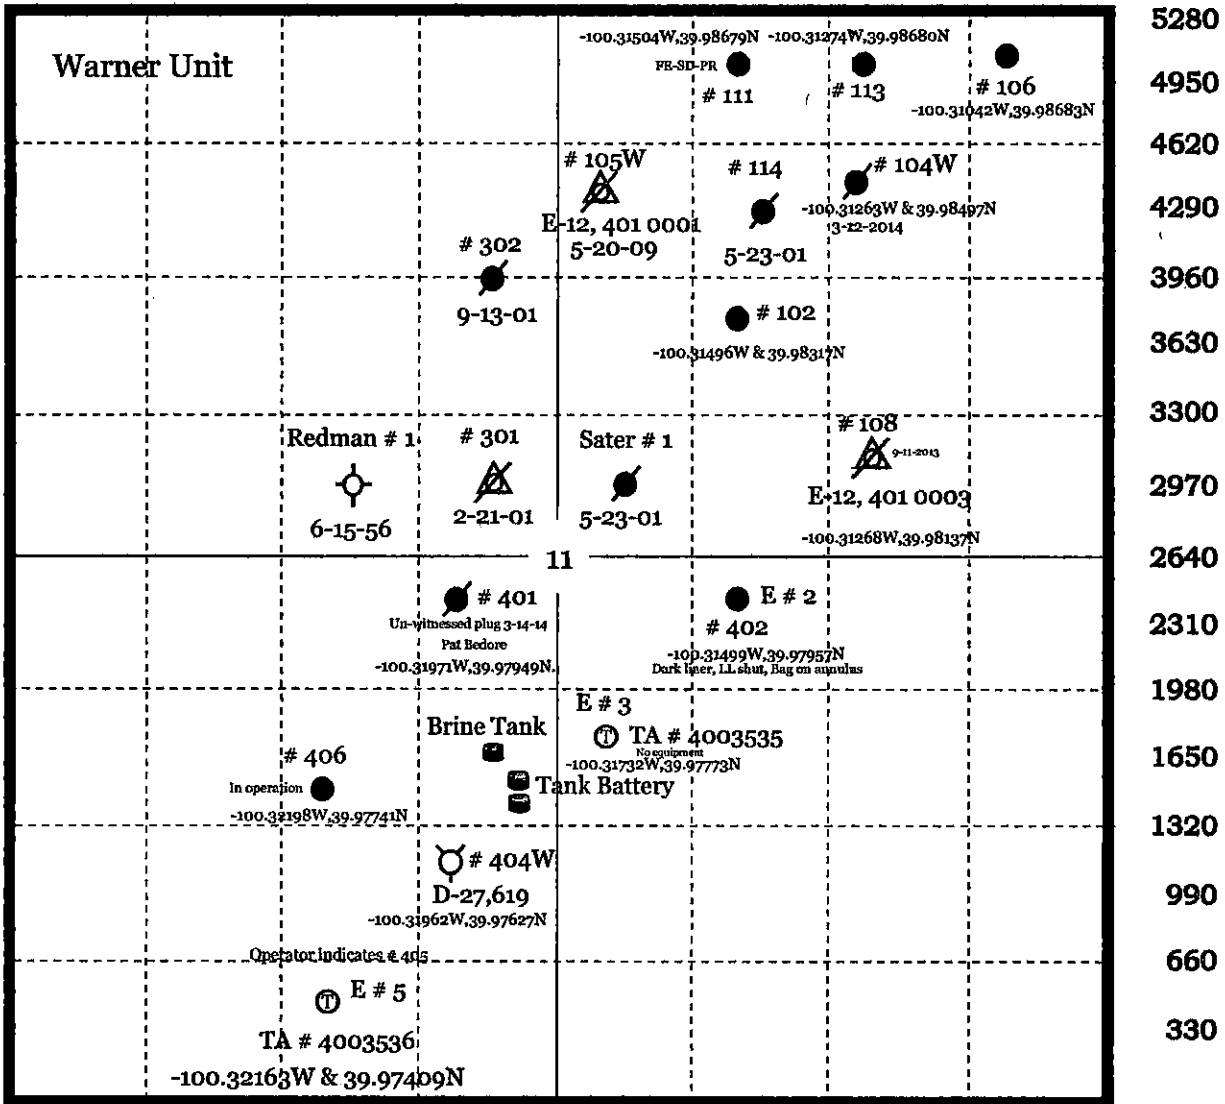

5280 4950 4620 4290 3960 3630 3300 2970 2640 2310 1980 1650 1320 990 660 330

- ⊗ Plugged SWD ⊙ SWD ⊕ Dry Hole ⊖ Temporary Abandoned
- ☀ Gas Well ⊗ Plugged Injection Well ● Oil Well ○ Abandoned
- ⊙ Water Supply Well ● Plugged Oil Well ☼ Tank Battery ⊕ Injection Well